

Annex C - Consolidated Drawing Schedule and revised drawings

Consolidated Drawing Schedule

	Column 1	Column 2	Column 3	Column 4
	Drawing number from Planning (Addendum 2) Drawing List	Link to redacted drawings on inquiry website	Link to location of unredacted indicative drawings	Nature of Remaining Redaction
1	B1_P11_09 Proposed basement floor plan, Johnson Smirke building	CD1.03C p2	INQ11 p42	<p>No redaction to the original drawing. The Rev 01 has been labelled to identify the principle use of the space in line with INQ11 p42 for information purposes. All information has been provided before the Inquiry.</p> <p>Use information for smaller rooms (areas with no public access) is not shown, which is however irrelevant to the planning.</p> <p><u>All works to heritage features shown</u></p>
2	B1_P11_10 Proposed ground floor plan, Johnson Smirke building	CD1.03C p3	Fig 6.10.4 p91 CD11.03 INQ11 p41	<p>No redaction to the original drawing. The Rev 01 has been labelled to identify the principle use of the space in line with CD11.03 p91 Fig 6.10.4 and INQ11 p41 for information purposes. All information has been provided before the Inquiry.</p> <p>Use information for smaller rooms (areas with no public access) is not shown, which is however irrelevant to the planning.</p> <p><u>All works to heritage features shown</u></p>
3	B1_P11_11 Proposed first floor plan, Johnson Smirke building	CD1.03C p4	Fig 6.10.3 p91 CD11.03 INQ11 p42	<p>No redaction to the original drawing. The Rev 01 has been labelled to identify the principle use of the space in line with CD11.03 p91 Fig 6.10.3 and INQ11 p42 for information purposes. All information has been provided before the Inquiry.</p> <p>Use information for smaller rooms (areas with no public access) is not shown, which is however irrelevant to the planning.</p> <p><u>All works to heritage features shown</u></p>
4	B1_P11_12 Proposed second floor plan, Johnson Smirke building	CD1.03C p5	INQ11 p43	<p>No redaction to the original drawing. The Rev 01 has been labelled to identify the principle use of the space in line with INQ11 p43 for information purposes. All information has been provided before the Inquiry.</p> <p>Use information for smaller rooms (areas with no public access) is not shown, which is however irrelevant to the planning.</p> <p><u>All works to heritage features shown</u></p>
5	B1_P11_13 Proposed third floor plan, Johnson Smirke building	CD1.03C p6	INQ11 p43	<p>No redaction to the original drawing. The Rev 01 has been labelled to identify the principle use of the space in line with INQ11 p43 for information purposes. All information has been provided before the Inquiry.</p> <p>Use information for smaller rooms (areas with no public access) is not shown, which is however irrelevant to the planning.</p> <p><u>All works to heritage features shown</u></p>

6	B1_P11_14 Proposed roof plan, Johnson Smirke building	CD1.03C p7		Unnecessarily listed as 'redacted' in the drawing register. No changes. All works to heritage features shown.
7	B2_P11_09 Proposed basement floor plan, Seaman's Registry Building	CD1.03C p18	INQ11 p52	No redaction to the original drawing. The Rev 01 has been labelled to identify the principle use of the space in line with INQ11 p52 for information purposes. All information has been provided before the Inquiry. Use information for remaining rooms (areas with no public access) is not shown, which is however irrelevant to the planning. <u>All works to heritage features shown</u>
8	B2_P11_10 Proposed ground floor plan, Seaman's Registry Building	CD1.03C p19	Fig 6.11.4 p93 CD11.03 Applicant PoE-Design INQ11 p53	No redaction to the original drawing. The Rev 01 has been labelled to identify the principle use of the space in line with CD11.03 p93 Fig 6.11.4 and INQ11 p53 (ground floor plan) for information purposes. All information has been provided before the Inquiry. Use information for remaining rooms (areas with no public access) is not shown, which is however irrelevant to the planning. <u>All works to heritage features shown</u>
9	B2_P11_11 Proposed first floor plan, Seaman's Registry Building	CD1.03C p20	Fig 6.11.3 p93 CD11.03 Applicant PoE-Design	No redaction to the original drawing. The Rev 01 has been labelled to identify the principle use of the space in line with CD11.03 p93 Fig 6.11.3 and INQ11 p53 (typical upper floor plan) for information purposes. All information has been provided before the Inquiry. Use information for remaining rooms (areas with no public access) is not shown, which is however irrelevant to the planning. <u>All works to heritage features shown</u>
10	B2_P11_12 Proposed second floor plan, Seaman's Registry Building	CD1.03C p21		No redaction to the original drawing. The Rev 01 has been labelled to identify the principle use of the space in line with INQ11 p53 (typical upper floor plan) for information purposes. All information has been provided before the Inquiry. Use information for remaining rooms (areas with no public access) is not shown, which is however irrelevant to the planning. <u>All works to heritage features shown</u>
11	B2_P11_13 Proposed third floor plan, Seaman's Registry Building	CD1.03C p22		No redaction to the original drawing. The Rev 01 has been labelled to identify the principle use of the space in line with INQ11 p53 (typical upper floor plan) for information purposes. All information has been provided before the Inquiry. Use information for remaining rooms (areas with no public access) is not shown, which is however irrelevant to the planning. <u>All works to heritage features shown</u>

12	B2_P11_14 Proposed fourth floor plan, Seaman's Registry Building	CD1.03C p23		<p>No redaction to the original drawing. The Rev 01 has been labelled to identify the principle use of the space for information purposes. All information has been provided before the Inquiry.</p> <p>Use information for remaining rooms (areas with no public access) is not shown, which is however irrelevant to the planning.</p> <p><u>All works to heritage features shown.</u></p>
13	B2_P11_15 Proposed roof floor plan, Seaman's Registry Building	CD1.03C p24		<p>Unnecessarily listed as 'redacted' in the drawing register. No changes.</p> <p>All works to heritage features shown.</p>
14	B3a_P11_09 Proposed basement plan, Cultural Exchange Building	CD1.03C p37	Fig 6.12.12 p99 CD11.03 Applicant PoE-Design INQ11 p60	<p>The Cultural Exchange Building layout in Rev 01 has been unredacted. The details are in line with CD11.03 p99 Fig6.12.12 and INQ11 p60. All information has been provided before the Inquiry.</p> <p>Use information for remaining rooms (areas with no public access) is not shown, which is however irrelevant to the planning.</p>
15	B3a_P11_10 Proposed upper ground floor plan, Cultural Exchange Building	CD1.03C p38	Fig 6.12.14 p99 CD11.03 Applicant PoE-Design INQ11 p61	<p>The Cultural Exchange Building layout in Rev 01 has been unredacted. The details are in line with CD11.03 p99 Fig6.12.14 and INQ11 p61. All information has been provided before the Inquiry.</p> <p>Use information for remaining rooms (areas with no public access) is not shown, which is however irrelevant to the planning.</p>
16	B3a_P11_11 Proposed first floor plan, Cultural Exchange Building	CD1.03C p39	INQ11 p62	<p>The Cultural Exchange Building layout in Rev 01 has been unredacted. The details are in line with INQ11 p62. All information has been provided before the Inquiry.</p> <p>Use information for remaining rooms (areas with no public access) is not shown, which is however irrelevant to the planning.</p>
17	B3a_P11_12 Proposed second floor plan, Cultural Exchange Building	CD1.03C p40	INQ11 p63	<p>The Cultural Exchange Building layout in Rev 01 has been unredacted. The details are in line with INQ11 p63 second floor layout. All information has been provided before the Inquiry.</p> <p>Use information for remaining rooms (areas with no public access) is not shown, which is however irrelevant to the planning.</p>
18	B3a_P11_13 Proposed third floor plan, Cultural Exchange Building	CD1.03C p41	INQ11 p63	<p>The Cultural Exchange Building layout in Rev 01 has been unredacted. The details are in line with INQ11 p63 third floor layout. All information has been provided before the Inquiry.</p> <p>Use information for remaining rooms (areas with no public access) is not shown, which is however irrelevant to the planning.</p>

19	B3a_P11_14 Proposed fourth floor plan, Cultural Exchange Building	CD1.03C p42	INQ11 p64	<p>The Cultural Exchange Building layout in Rev 01 has been unredacted. The details are in line with INQ11 p64 fourth floor layout. All information has been provided before the Inquiry.</p> <p>Use information for remaining rooms (areas with no public access) is not shown, which is however irrelevant to the planning.</p>
20	B3a_P11_15 Proposed fifth floor plan, Cultural Exchange Building	CD1.03C p43	INQ11 p64	<p>The Cultural Exchange Building layout in Rev 01 has been unredacted. The details are in line with INQ11 p64 fifth floor layout. All information has been provided before the Inquiry.</p> <p>Use information for remaining rooms (areas with no public access) is not shown, which is however irrelevant to the planning.</p>
21	B3a_P11_16 Proposed sixth floor plan, Cultural Exchange Building	CD1.03C p44		<p>The Cultural Exchange Building layout in Rev 01 has been unredacted. All information has been provided before the Inquiry.</p> <p>Use information for remaining rooms (areas with no public access) is not shown, which is however irrelevant to the planning.</p>
22	B3a_P11_17 Proposed roof plan, Cultural Exchange Building	CD1.03C p45		Unnecessarily listed as 'redacted' in the drawing register. No changes.
23	B3b_P11_08 Proposed basement plan, Embassy House, North	CD7.05 1510_A_B3b_11_08_01		<p>The Embassy House layout in Rev 02 has been unredacted. All information has been provided before the Inquiry.</p> <p>Use information for the remaining spaces (areas with no public access) is not shown, which is however irrelevant to the planning.</p>
24	B3b_P11_09 Proposed basement plan, Embassy House, South	CD7.05 1510_A_B3b_11_09_01		<p>The Embassy House layout in Rev 02 has been unredacted. All information has been provided before the Inquiry.</p> <p>Use information for the remaining spaces (areas with no public access) is not shown, which is however irrelevant to the planning.</p>
25	B3b_P11_10 Proposed ground floor plan, Embassy House, North	CD7.05 1510_A_B3b_11_10_01	Fig 6.13.6 p104 CD11.03 Applicant PoE-Design INQ11 p78	<p>The Embassy House layout in Rev 02 has been unredacted. The details are in line with CD11.03 p104 Fig 6.13.6 and INQ11 p78. All information has been provided before the Inquiry.</p> <p>Use information for the remaining spaces (areas with no public access) is not shown, which is however irrelevant to the planning.</p>
26	B3b_P11_11 Proposed ground floor plan, Embassy House, South	CD7.05 1510_A_B3b_11_11_01	Fig 6.13.6 p104 CD11.03 Applicant PoE-Design	<p>The Embassy House layout in Rev 02 has been unredacted. The details are in line with CD11.03 p104 Fig 6.13.6. All information has been provided before the Inquiry.</p> <p>Use information for the remaining spaces (areas with no public access) is not shown, which is however irrelevant to the planning.</p>

27	B3b_P11_12 Proposed first floor plan, Embassy House, North	CD7.05 1510_A_B3b_11_12_01		The Embassy House layout in Rev 02 has been unredacted. The details are in line with INQ11 p79 Embassy House typical floor plan. All information has been provided before the Inquiry. Layouts of the units are shown in separate Unit Layout Plan.
28	B3b_P11_13 Proposed first floor plan, Embassy House, South	CD7.05 1510_A_B3b_11_13_01		The Embassy House layout in Rev 02 has been unredacted. The details are in line with INQ11 p79 Embassy House typical floor plan. All information has been provided before the Inquiry. Layouts of the units are shown in separate Unit Layout Plan.
29	B3b_P11_14 Proposed second floor plan, Embassy House, North	CD7.05 1510_A_B3b_11_14_01		The Embassy House layout in Rev 02 has been unredacted. The details are in line with INQ11 p79 Embassy House typical floor plan. All information has been provided before the Inquiry. Layouts of the units are shown in separate Unit Layout Plan.
30	B3b_P11_15 Proposed second floor plan, Embassy House, South	CD7.05 1510_A_B3b_11_15_01		The Embassy House layout in Rev 02 has been unredacted. The details are in line with INQ11 p79 Embassy House typical floor plan. All information has been provided before the Inquiry. Layouts of the units are shown in separate Unit Layout Plan.
31	B3b_P11_16 Proposed third floor plan, Embassy House, North	CD7.05 1510_A_B3b_11_16_01		The Embassy House layout in Rev 02 has been unredacted. The details are in line with INQ11 p79 Embassy House typical floor plan. All information has been provided before the Inquiry. Layouts of the units are shown in separate Unit Layout Plan.
32	B3b_P11_17 Proposed third floor plan, Embassy House, South	CD7.05 1510_A_B3b_11_17_01		The Embassy House layout in Rev 02 has been unredacted. The details are in line with INQ11 p79 Embassy House typical floor plan. All information has been provided before the Inquiry. Layouts of the units are shown in separate Unit Layout Plan.
33	B3b_P11_18 Proposed fourth floor plan, Embassy House, North	CD7.05 1510_A_B3b_11_18_01		The Embassy House layout in Rev 02 has been unredacted. The details are in line with INQ11 p79 Embassy House typical floor plan. All information has been provided before the Inquiry. Layouts of the units are shown in separate Unit Layout Plan.
34	B3b_P11_19 Proposed fourth floor plan, Embassy House, South	CD7.05 1510_A_B3b_11_19_01		The Embassy House layout in Rev 02 has been unredacted. The details are in line with INQ11 p79 Embassy House typical floor plan. All information has been provided before the Inquiry. Layouts of the units are shown in separate Unit Layout Plan.


35	B3b_P11_20 Proposed fifth floor plan, Embassy House, North	CD7.05 1510_A_B3b_11_20_01		The Embassy House layout in Rev 02 has been unredacted. The details are in line with INQ11 p79 Embassy House typical floor plan. All information has been provided before the Inquiry. Layouts of the units are shown in separate Unit Layout Plan.
36	B3b_P11_21 Proposed fifth floor plan, Embassy House, South	CD7.05 1510_A_B3b_11_21_01		The Embassy House layout in Rev 02 has been unredacted. The details are in line with INQ11 p79 Embassy House typical floor plan. All information has been provided before the Inquiry. Layouts of the units are shown in separate Unit Layout Plan.
37	B3b_P11_22 Proposed sixth floor plan, Embassy House, North	CD7.22 1510_A_B3b_11_22	Fig 6.13.8 p105 CD11.03 Applicant PoE-Design INQ11 p80	The Embassy House layout in Rev 03 has been unredacted. The details are in line with CD11.03p105 Fig 6.13.8 and INQ11 p80. All information has been provided before the Inquiry Layouts of the units are shown in separate Unit Layout Plan.
38	B3b_P11_23 Proposed sixth floor plan, Embassy House, South	CD7.22 1510_A_B3b_11_23	Fig 6.13.8 p105 CD11.03 Applicant PoE-Design INQ11 p80	The Embassy House layout in Rev 03 has been unredacted. The details are in line with CD11.03p105 Fig 6.13.8 and INQ11 p80. All information has been provided before the Inquiry Layouts of the units are shown in separate Unit Layout Plan.
39	B3b_P11_24 Proposed seventh floor plan, Embassy House, North	CD7.22 1510_A_B3b_11_24		The Embassy House layout in Rev 03 has been unredacted. All information has been provided before the Inquiry
40	B3b_P11_25 Proposed seventh floor plan, Embassy House, South	CD7.22 1510_A_B3b_11_25		The Embassy House layout in Rev 03 has been unredacted. All information has been provided before the Inquiry
41	B3b_P11_26 Proposed roof floor plan, Embassy House, North	CD7.22 1510_A_B3b_11_26	Fig 6.13.7 p105 CD11.03 Applicant PoE-Design INQ11 p80	The Embassy House layout in Rev 03 has been unredacted. The details are in line with CD11.03p105 Fig 6.13.7 and INQ11 p80. All information has been provided before the Inquiry.
42	B3b_P11_27 Proposed roof floor plan, Embassy House, South	CD7.22 1510_A_B3b_11_27	Fig 6.13.7 p105 CD11.03 Applicant PoE-Design INQ11 p80	The Embassy House layout in Rev 03 has been unredacted. The details are in line with CD11.03p105 Fig 6.13.7 and INQ11 p80. All information has been provided before the Inquiry.
43	B3b_P21_11 Proposed unit flat layouts, Embassy House	CD7.22 1510_A_B3b_21_11_Unit layouts		Unnecessarily listed as 'redacted' in the drawing register. No changes.
44	B3b_P21_12 Proposed unit flat layouts, Embassy House	CD7.22 1510_A_B3b_21_12_Unit layouts		Unnecessarily listed as 'redacted' in the drawing register. No changes.

45	B4_11_05 Location plan, Proposed scheme	CD1.03C p86		Unnecessarily listed as 'redacted' in the drawing register. No changes.
46	B4_11_08 Site plan, Proposed scheme	CD1.03C p87		Unnecessarily listed as 'redacted' in the drawing register. No changes.
47	B4_11_09 Proposed basement plan, Masterplan	CD7.05 1510_A_B4_11_09_01		The Proposed basement master plan in Rev 02 has been unredacted. All information has been provided before the Inquiry.
48	B4_11_10 Proposed ground floor plan, Masterplan	CD7.05 1510_A_B4_11_10_01		The Proposed ground floor master plan in Rev 02 has been unredacted. All information has been provided before the Inquiry.
49	B4_11_11 Proposed roof plan, Masterplan	CD7.22 1510_A_B4_11_11		Unnecessarily listed as 'redacted' in the drawing register. No changes.
50	B4_11_12 Proposed paving plan, Masterplan	CD7.22 1510_A_B4_11_12_01		The Proposed paving master plan in Rev 02 has been unredacted. All information has been provided before the Inquiry
51	B4_11_19 Proposed works on Cartwright Street, Masterplan	CD1.03C p92		Unnecessarily listed as 'redacted' in the drawing register. No changes.
52	B4_P11_21 Proposed ground floor plan, Masterplan, Entrance pavilion	CD1.03C p107		No redaction to the original drawing. The Rev 01 has been labelled to identify the security check room. All information has been provided before the Inquiry. Use information for smaller rooms (areas with no public access) is not shown, which is however irrelevant to the planning. <u>All works to heritage features shown.</u>

Revised Drawings Schedule

- 1 1510_A_B1-_P11_09 Proposed basement floor plan - Johnson Smirke building Rev 01
- 2 1510_A_B1-_P11_10 Proposed ground floor plan - Johnson Smirke building Rev 01
- 3 1510_A_B1-_P11_11 Proposed first floor plan - Johnson Smirke building Rev 01
- 4 1510_A_B1-_P11_12 Proposed second floor plan - Johnson Smirke building Rev 01
- 5 1510_A_B1-_P11_13 Proposed third floor plan - Johnson Smirke building Rev 01
- 6 1510_A_B2-_P11_09 Proposed basement plan - Seaman's Registry building Rev 01
- 7 1510_A_B2-_P11_10 Proposed ground floor plan - Seaman's Registry building Rev 01
- 8 1510_A_B2-_P11_11 Proposed first floor plan - Seaman's Registry building Rev 01
- 9 1510_A_B2-_P11_12 Proposed second floor plan - Seaman's Registry building Rev 01
- 10 1510_A_B2-_P11_13 Proposed third floor plan - Seaman's Registry building Rev 01
- 11 1510_A_B2-_P11_14 Proposed fourth floor plan - Seaman's Registry building Rev 01
- 12 1510_A_B3A_11_09 Proposed Basement Plan - Cultural Exchange Building Rev 01
- 13 1510_A_B3A_11_10 Proposed Ground Floor Plan - Cultural Exchange Building Rev 01
- 14 1510_A_B3A_11_11 Proposed First Floor Plan - Cultural Exchange Building Rev 01
- 15 1510_A_B3A_11_12 Proposed Second Floor Plan - Cultural Exchange Building Rev 01
- 16 1510_A_B3A_11_13 Proposed Third Floor Plan - Cultural Exchange Building Rev 01
- 17 1510_A_B3A_11_14 Proposed Fourth Floor Plan - Cultural Exchange Building Rev 01
- 18 1510_A_B3A_11_15 Proposed Fifth Floor Plan - Cultural Exchange Building Rev 01
- 19 1510_A_B3A_11_16 Proposed Sixth Floor Plan - Cultural Exchange Building Rev 01
- 20 1510_A_B3b_11_08 Proposed Basement Plan - Embassy House North - Sheet 1 of 2 Rev 02
- 21 1510_A_B3b_11_09 Proposed Basement Plan - Embassy House South - Sheet 2 of 2 Rev 02
- 22 1510_A_B3b_11_10 Proposed Ground Floor Plan - Embassy House North - Sheet 1 of 2 Rev 02
- 23 1510_A_B3b_11_11 Proposed Ground Floor Plan - Embassy House South - Sheet 2 of 2 Rev 02
- 24 1510_A_B3b_11_12 Proposed First Floor Plan - Embassy House North - Sheet 1 of 2 Rev 02
- 25 1510_A_B3b_11_13 Proposed First Floor Plan - Embassy House South - Sheet 2 of 2 Rev 02
- 26 1510_A_B3b_11_14 Proposed Second Floor Plan - Embassy House North - Sheet 1 of 2 Rev 02
- 27 1510_A_B3b_11_15 Proposed Second Floor Plan - Embassy House South - Sheet 2 of 2 Rev 02
- 28 1510_A_B3b_11_16 Proposed Third Floor Plan - Embassy House North - Sheet 1 of 2 Rev 02
- 29 1510_A_B3b_11_17 Proposed Third Floor Plan - Embassy House South - Sheet 2 of 2 Rev 02
- 30 1510_A_B3b_11_18 Proposed Fourth Floor Plan - Embassy House North - Sheet 1 of 2 Rev 02
- 31 1510_A_B3b_11_19 Proposed Fourth Floor Plan - Embassy House South - Sheet 2 of 2 Rev 02
- 32 1510_A_B3b_11_20 Proposed Fifth Floor Plan - Embassy House North - Sheet 1 of 2 Rev 02
- 33 1510_A_B3b_11_21 Proposed Fifth Floor Plan - Embassy House South - Sheet 2 of 2 Rev 02
- 34 1510_A_B3b_11_22 Proposed Sixth Floor Plan - Embassy House North - Sheet 1 of 2 Rev 03
- 35 1510_A_B3b_11_23 Proposed Sixth Floor Plan - Embassy House South - Sheet 2 of 2 Rev 03
- 36 1510_A_B3b_11_24 Proposed Seventh Floor Plan - Embassy House North - Sheet 1 of 2 Rev 03
- 37 1510_A_B3b_11_25 Proposed Seventh Floor Plan - Embassy House South - Sheet 2 of 2 Rev 03
- 38 1510_A_B3b_11_26 Proposed Roof Floor Plan - Embassy House North - Sheet 1 of 2 Rev 03
- 39 1510_A_B3b_11_27 Proposed Roof Floor Plan - Embassy House South - Sheet 2 of 2 Rev 03
- 40 1510_A_B4-_11_09 Proposed Basement Plan – Masterplan Rev 02
- 41 1510_A_B4-_11_10 Proposed Ground Floor Plan – Masterplan Rev 02
- 42 1510_A_B4-_11_12 Proposed Paving Plan – Masterplan Rev 02
- 43 1510_A_B4-_P11_21 Proposed Ground Floor Plan - Masterplan - Entrance Pavilion Rev 01

Revised Drawings

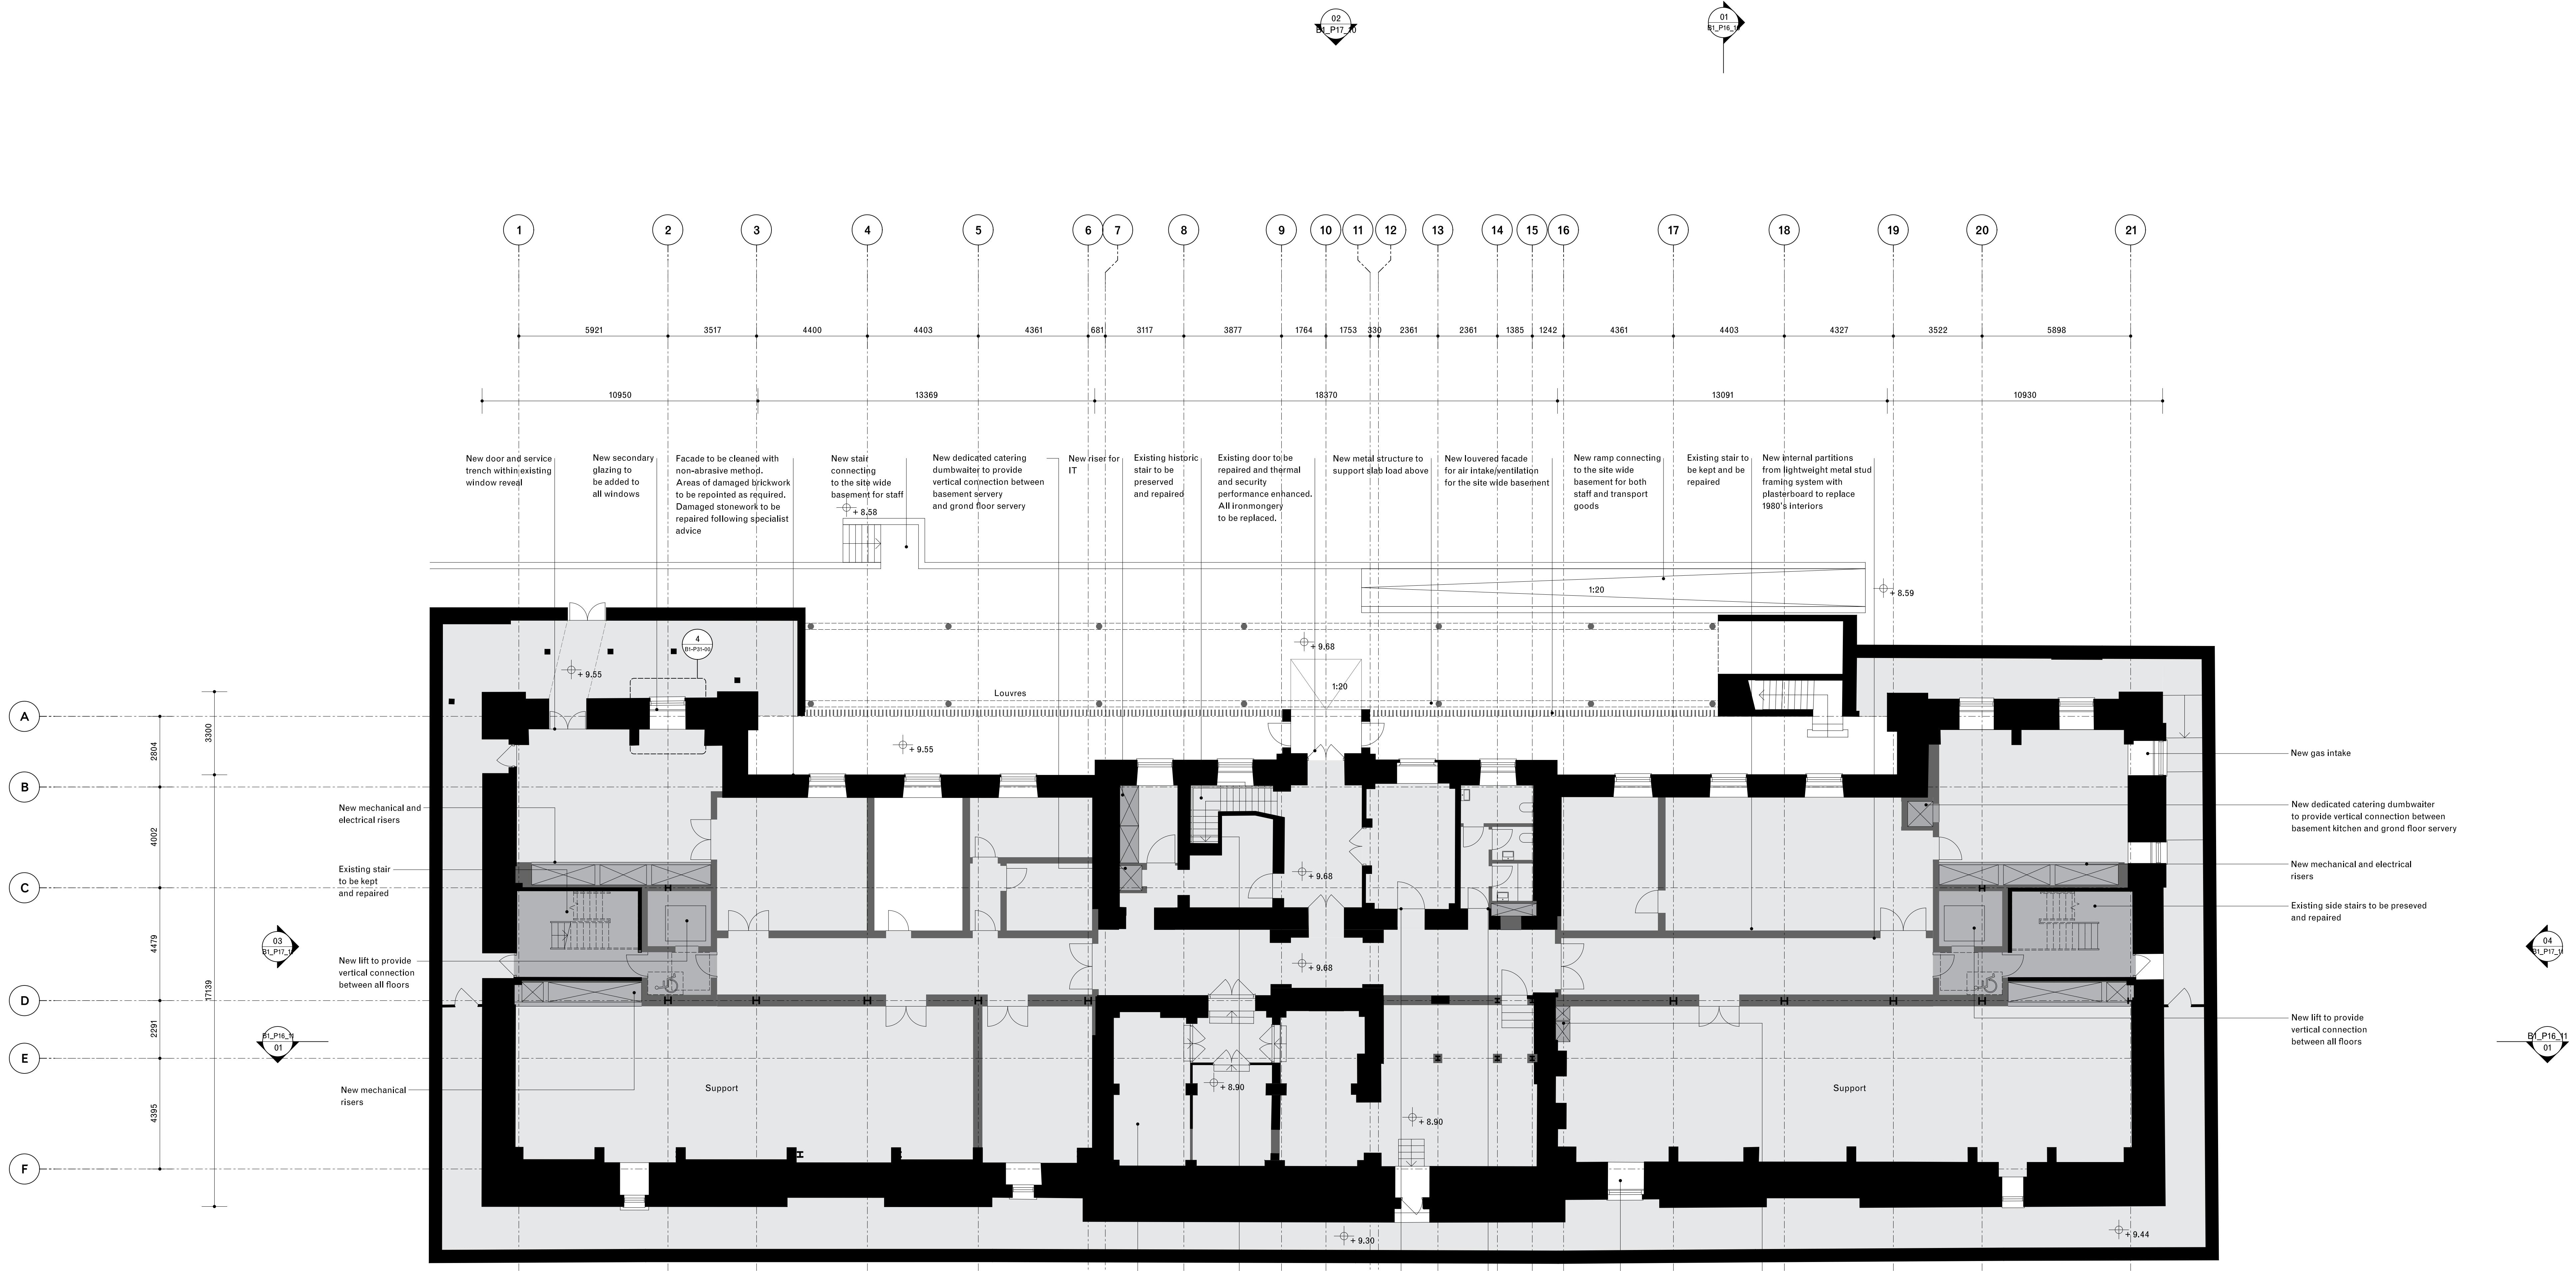

01 Proposed basement floor plan, Johnson Smirke building
Scale 1:100

David Chipperfield Architects

C/O Fora, 9 Dallington Street
London EC1V 0LN
T +44 20 7820 4800

Project **Royal Mint Court**

Client


Planning Application and Listed Building C (Addendum)

Proposed basement floor plan

Johnson Smirke building

Date **16/05/2024**
Scale / Format **1:100 / A0**

Drawn, Checked **ISI, SCA, SS**
Approved **BB**
CAD Reference 1510_A_B1-_P11_09.dgn

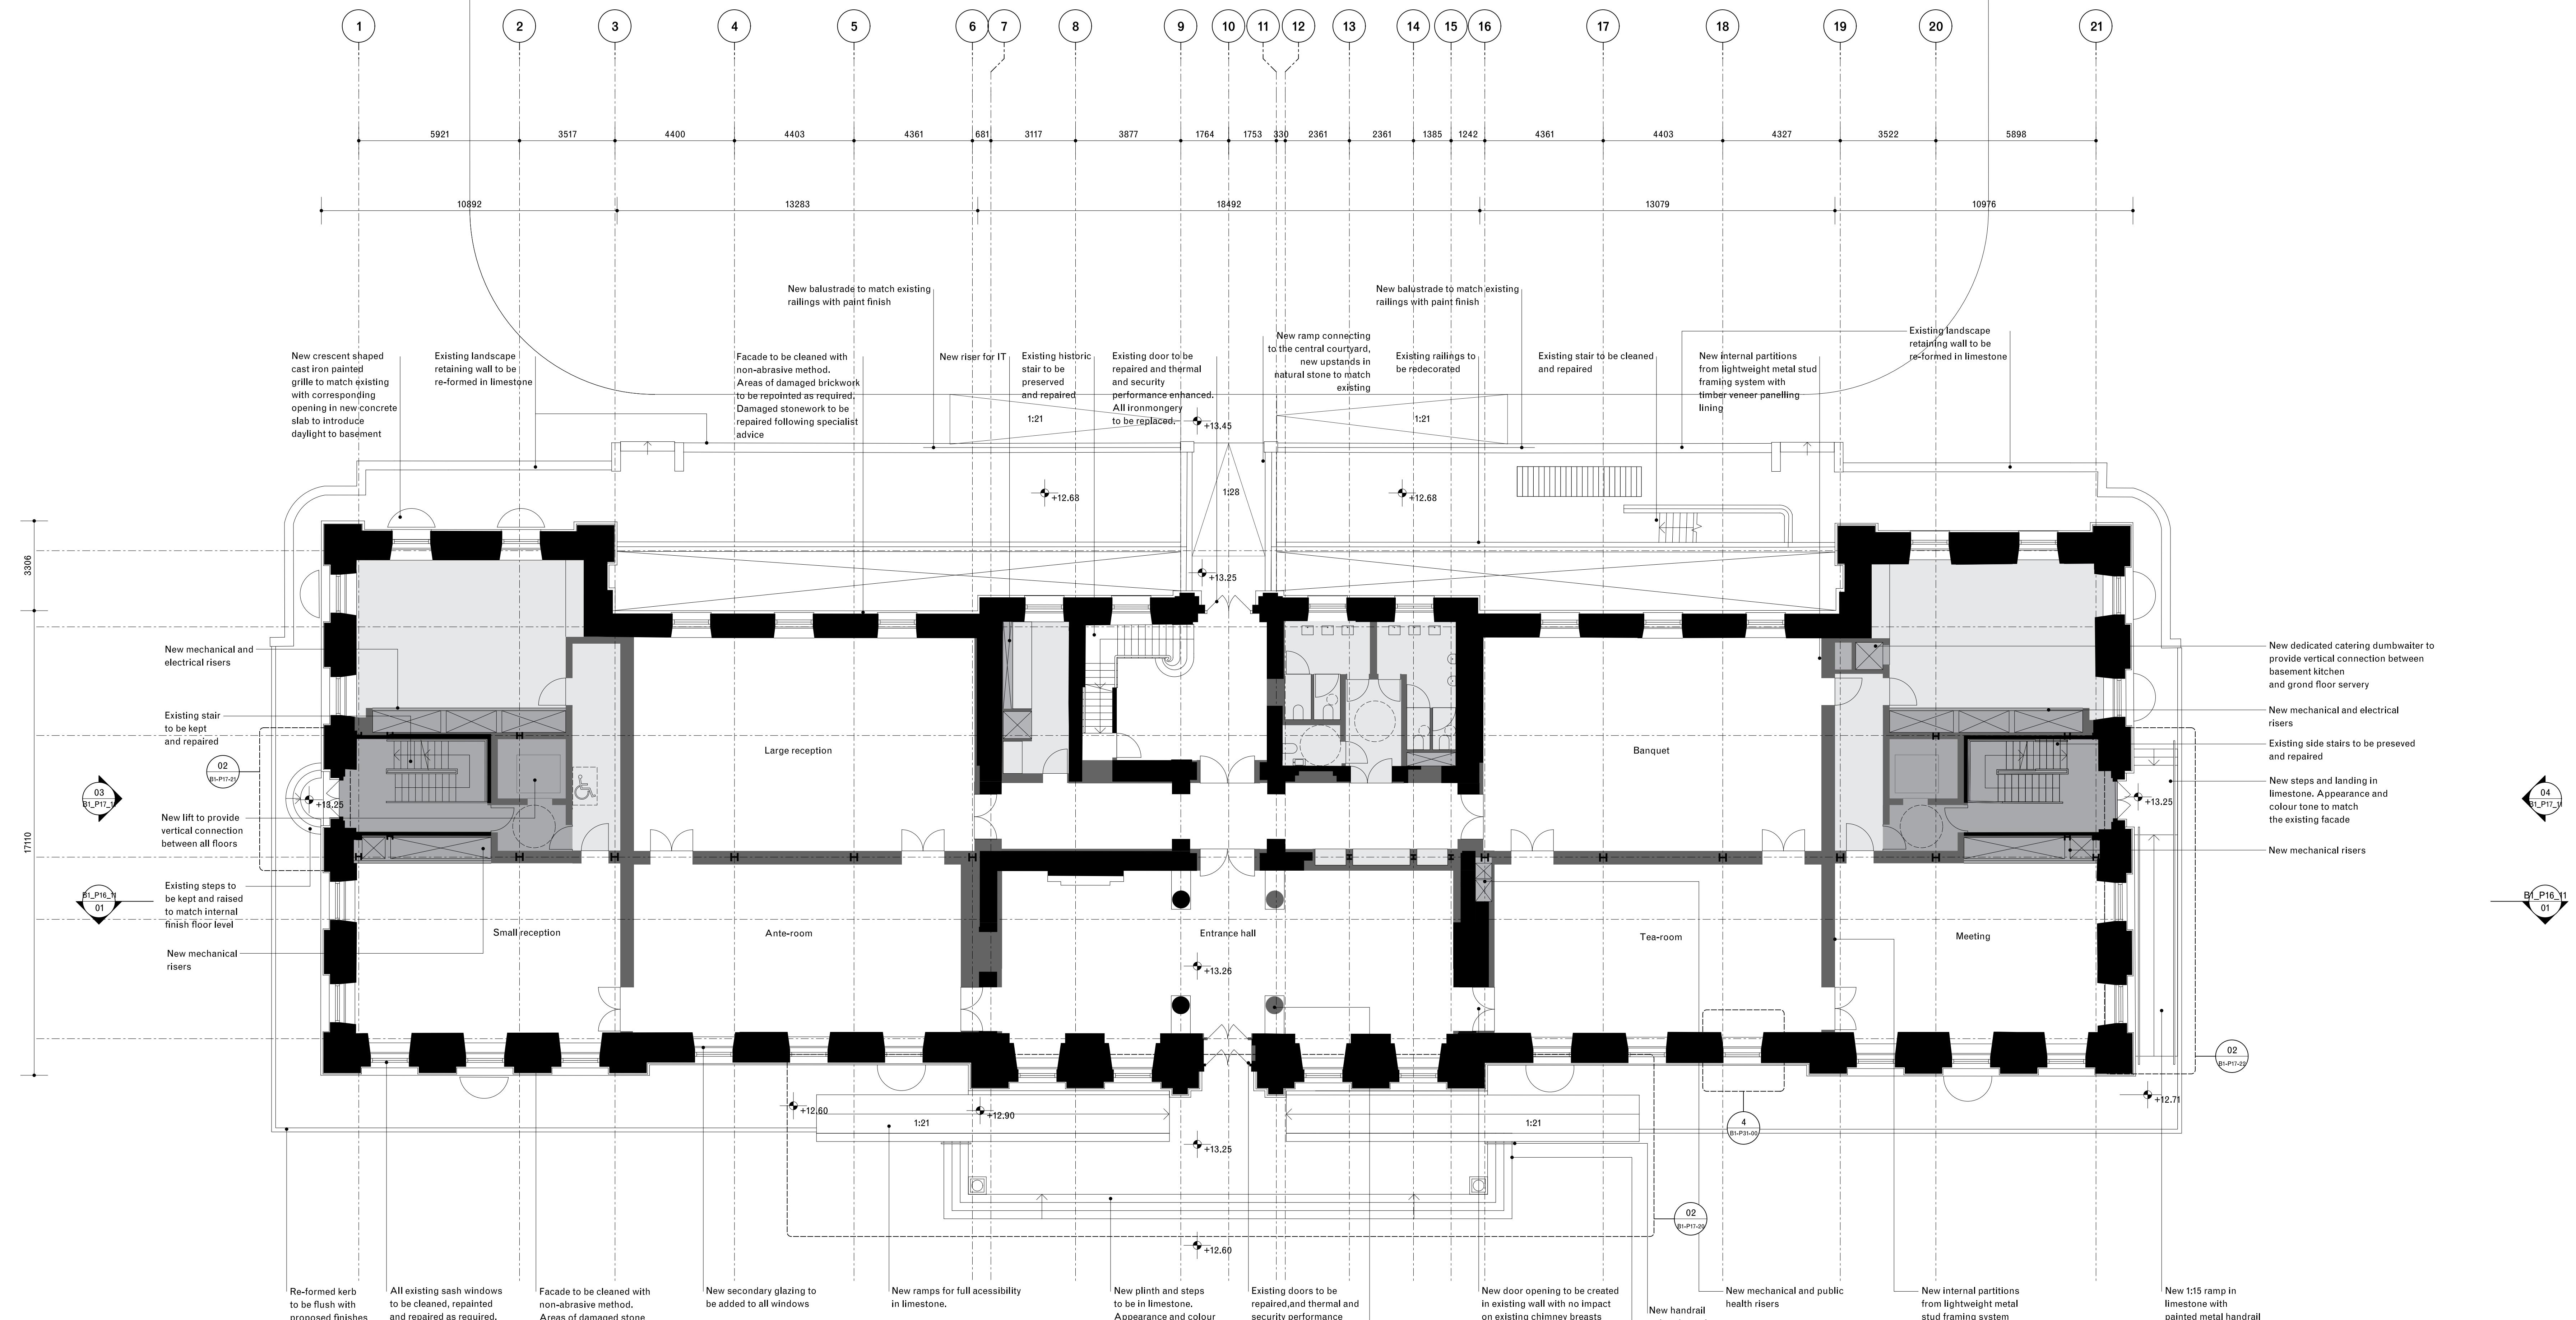

© David Chipperfield Architects Ltd.
100/200/2009/Planning (Addendum 3)
Rev. Date Description Drawn GLA Check

Project Royal Mint Court Project number 1510

Client Chinese Embassy in the UK

Planning Application and Listed Building Consent (Addendum)

Drawing name Proposed ground floor plan Drawing number B1-P11_10

Date 16/05/2024 Scale 1:100 / A0 Revision 01
Drawing / Checked B1 / OU
Approved B1
CAD Reference 1510_A_B1_P11_10.dgn

01 Proposed ground floor plan, Johnson Smirke building
Scale 1:100

01
B1-P11_10

01
B1-P11_10

C/O Fora, 9 Dallington Street
London EC1V 9DZ
T +44 20 7629 8800
www.davidchipperfield.com

 
Project Royal Mint Court Project number 1510

 
Client Chinese Embassy in the UK

Planning Application and Listed Building Consent (Addendum)

Drawing name Proposed ground floor plan Drawing number B1-P11_10

Date 16/05/2024 Scale 1:100 / A0 Revision 01
Drawing / Checked B1 / OU
Approved B1
CAD Reference 1510_A_B1_P11_10.dgn





01 Proposed second floor plan, Johnson Smirke building
Scale 1:100

Proposed second floor plan, Johnson Smirke bu

Scale 1:100

01
B1 P17 10

01
P16_10

C/O Fora, 9 Dallington Street
London EC1V 0LN
T +44 20 7620 4800
www.davidchipperfield.com

Project

Royal Mint Court

Client

 
Chinese Embassy in the UK

 
Planning Application and Listed Building (Addendum)

Proposed second floor plan Johnson Smirke building

Date **16/05/2024**
Scale / Format **1:100 / A0**
Drawn / Checked **ISP / GLa / OJU**

Approved **B**
CAD Reference 1510_A_B1-_P11_12.dgn





Existing

Proposed

 
General notes:

Do not scale from drawings.
 Errors to be reported immediately to the Architect.
 To be read in conjunction with all relevant Architects', Services and Structural Engineers' drawings.
 All existing site, tree and building information has been compiled from different sources.
 All dimensions to be checked on site.

01 20/08/2025 Planning (addendum 3) MY GLa

Rev. Date Description Drawn Check

C/O Fora, 9 Dallington Street
London EC1V 0LN
T +44 20 7620 4800
www.davidchipperfield.com



© David Chipperfield Architects


 
(Addendum)

Proposed ground floor plan B2- P11
Seaman's Registry building

Seaman's Registry building

Date **16/05/2024** Ref. No. **123456**
Scale / Format **1:100 / A0**

Scale / Format **1:100 / A0**
Drawn / Checked **CC, Dlt / GLa / OU**
Approved **BB**

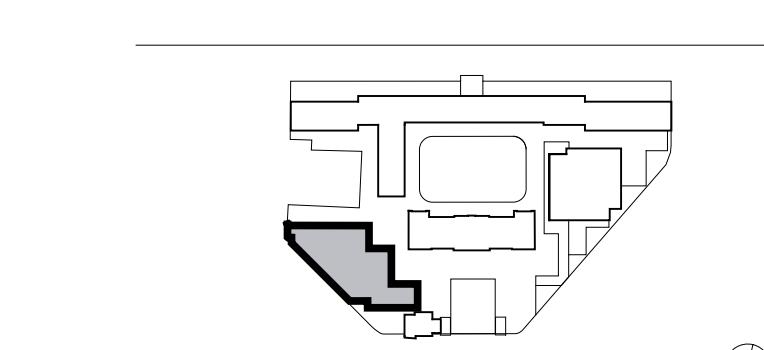

David Chipperfield Architects

CIO Fora, 9 Dallington Street
London EC2M 7DZ
T +44 20 7629 8800
www.davidchipperfield.com

Project: Royal Mint Court

Project number: 1510

Client: Chinese Embassy in the UK

Planning Application and Listed Building Consent
(Addendum)

Drawing name: Proposed first floor plan
Seaman's Registry building

 
Drawing number: B2_P11_11

Date: 16/05/2024
Scale / Format: 1:100 / A0
Arch. / Ctr. / GLs / OU
Approved

Revision: 01

Planning

CAD Reference: 1510_A_B2_P11_1.dgn



General notes:


- Do not scale from drawings.
- Errors to be reported immediately to the Architect.
- To be read in conjunction with all relevant Architects', Services and Structural Engineers' drawings.
- All existing site, tree and building information has been compiled from different sources.
- All dimensions to be checked on site.


An architectural floor plan of a building with a complex layout of rooms and hallways. A large, irregularly shaped area in the bottom-left corner is filled with a solid gray color, while the rest of the building is outlined in black. The plan includes various rooms of different sizes, some with internal partitions, and a central area with a large, irregularly shaped opening.

David Chipperfield Architects

Project	Project number
Royal Mint Court	1510
<hr/>	
Client	Chinese Embassy in the UK

  © David Chipperfield Architects Ltd.





General notes:


- Do not scale from drawings.
- Errors to be reported immediately to the Architect.
- To be read in conjunction with all relevant Architects', Services and Structural Engineers' drawings.
- All existing site, tree and building information has been compiled from different sources.
- All dimensions to be checked on site.

An architectural floor plan of a building with a complex, multi-level layout. The plan is composed of various rooms and spaces, some of which are shaded in gray. A large, irregularly shaped area in the bottom-left corner is filled with a dark gray color, while the rest of the building's structure is outlined in black. The plan includes several rectangular rooms, a central rectangular space, and a series of stairs and levels that connect different parts of the building.


David Chipperfield Architects


Project	Project number
Royal Mint Court	1510
<hr/>	
Client	Chinese Embassy in the UK


© David Chipperfield Architects Ltd.

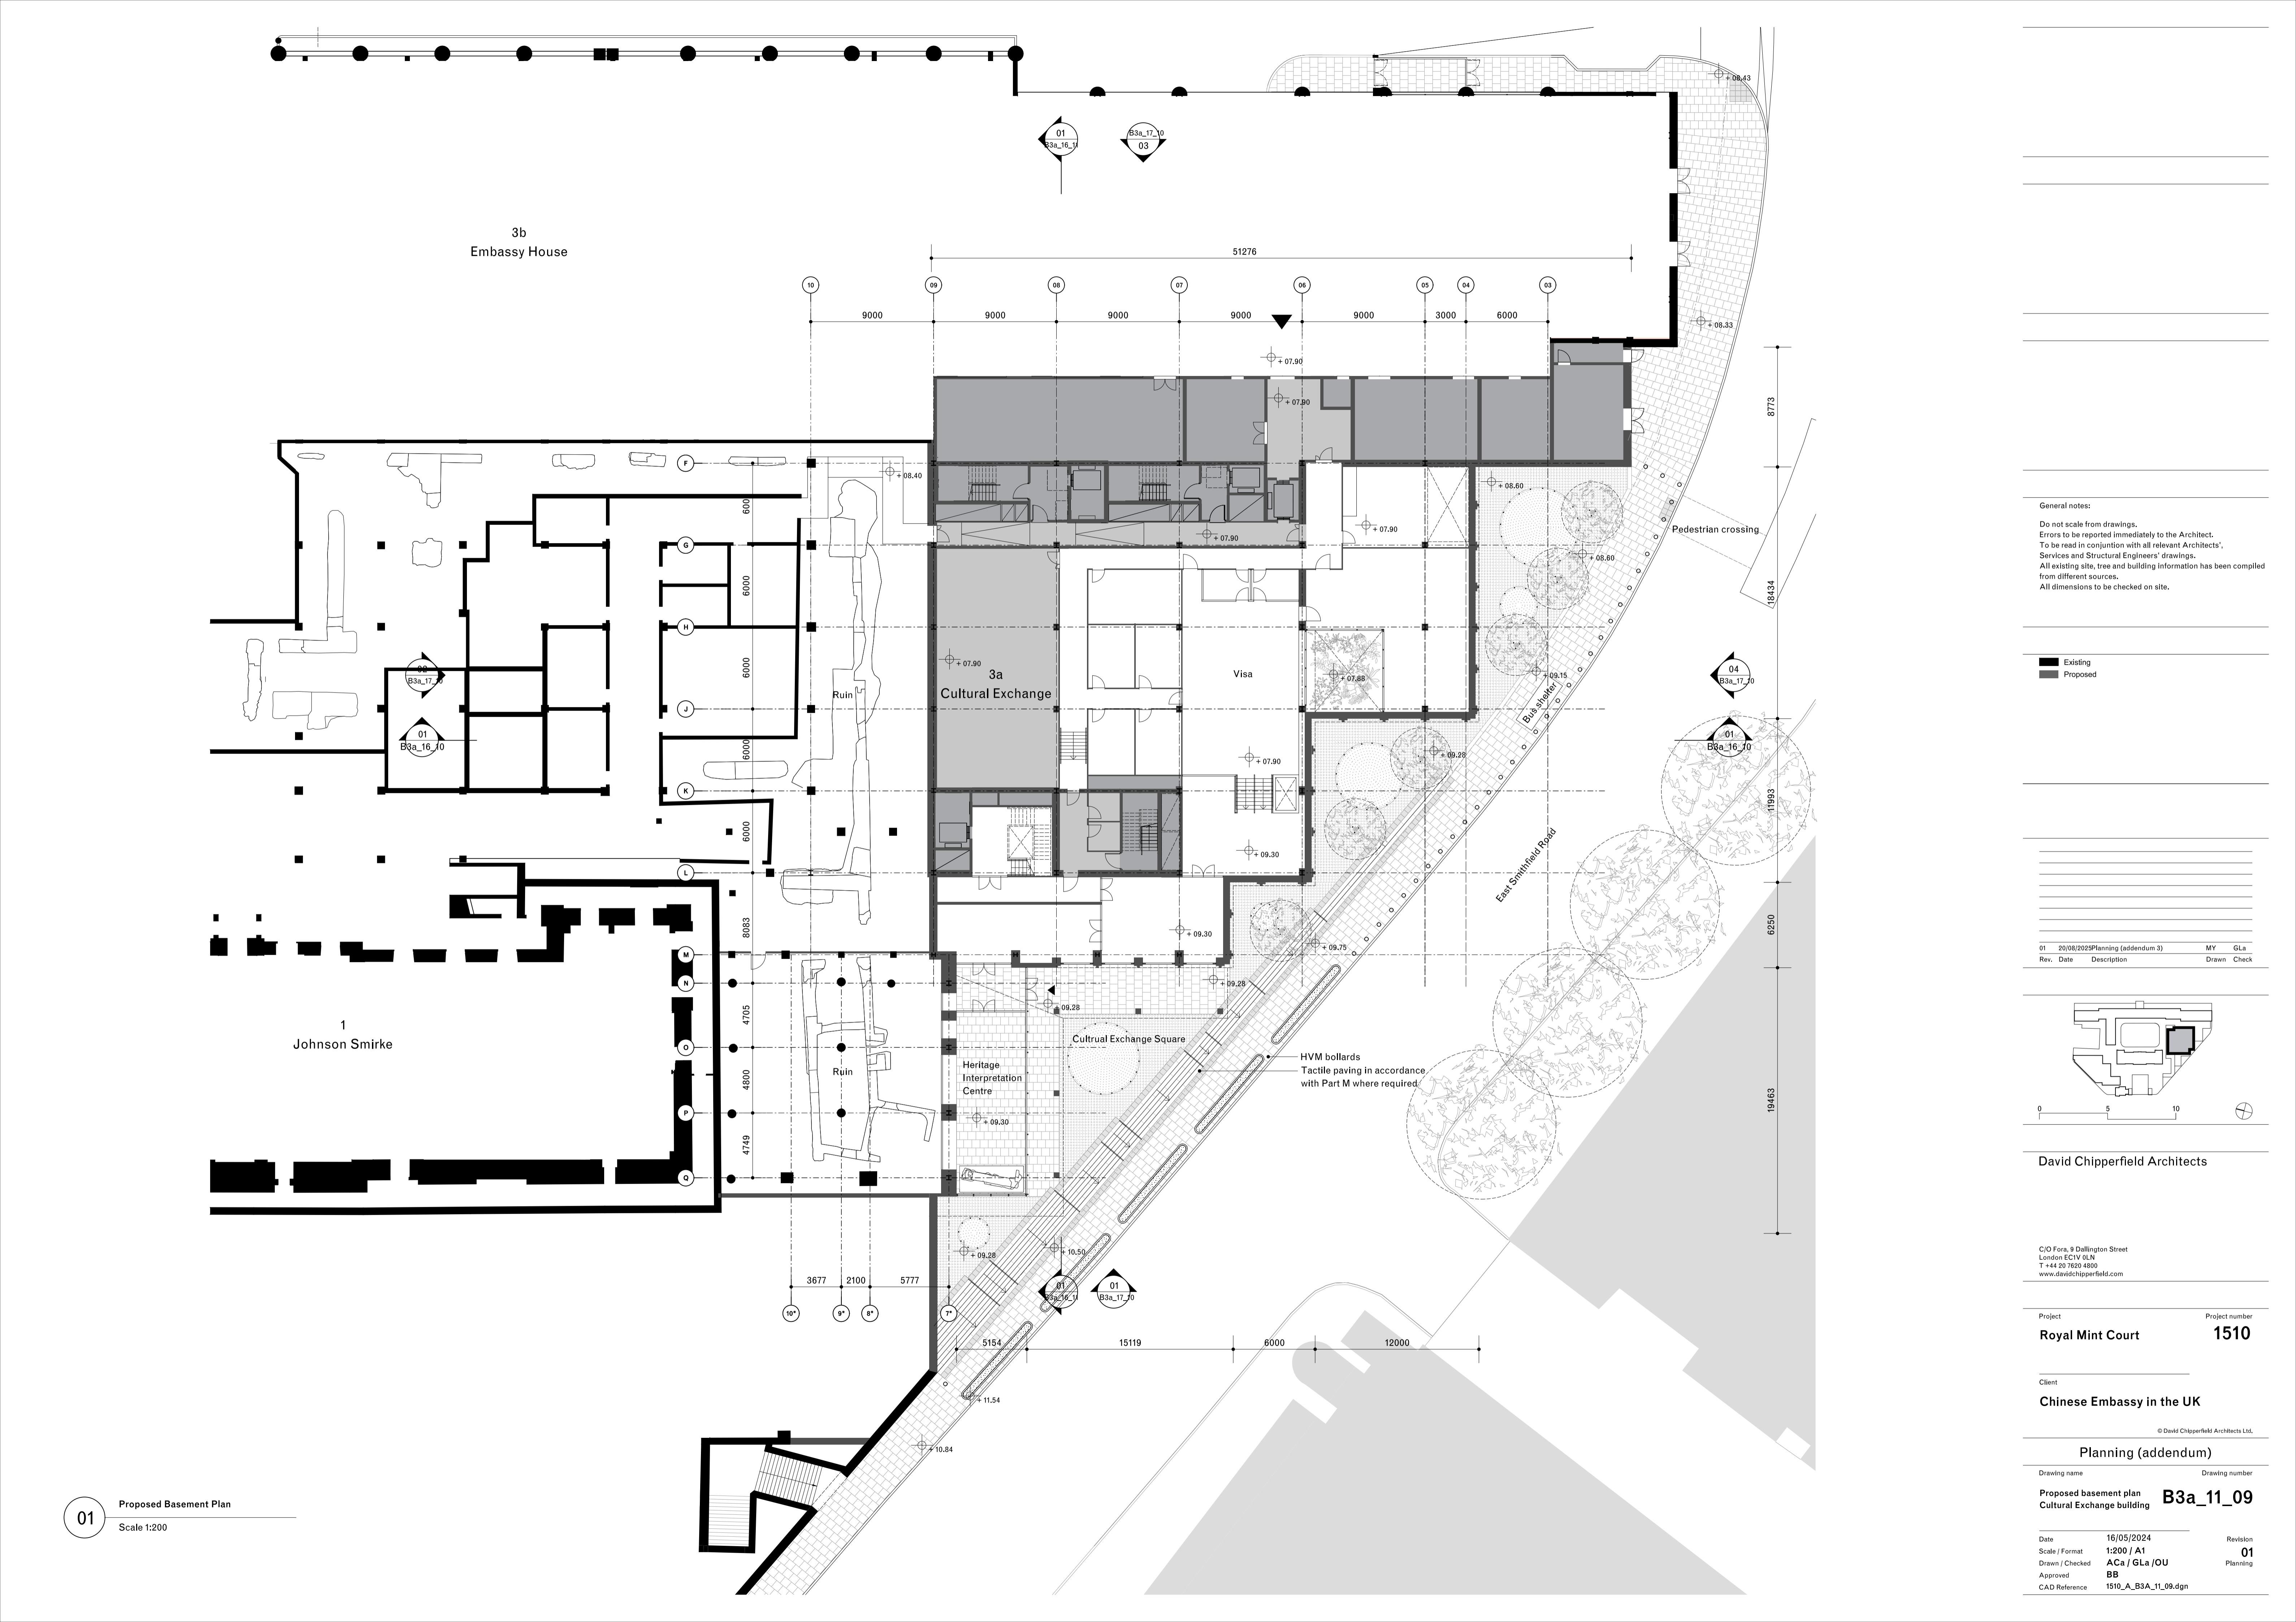

3b
Embassy House

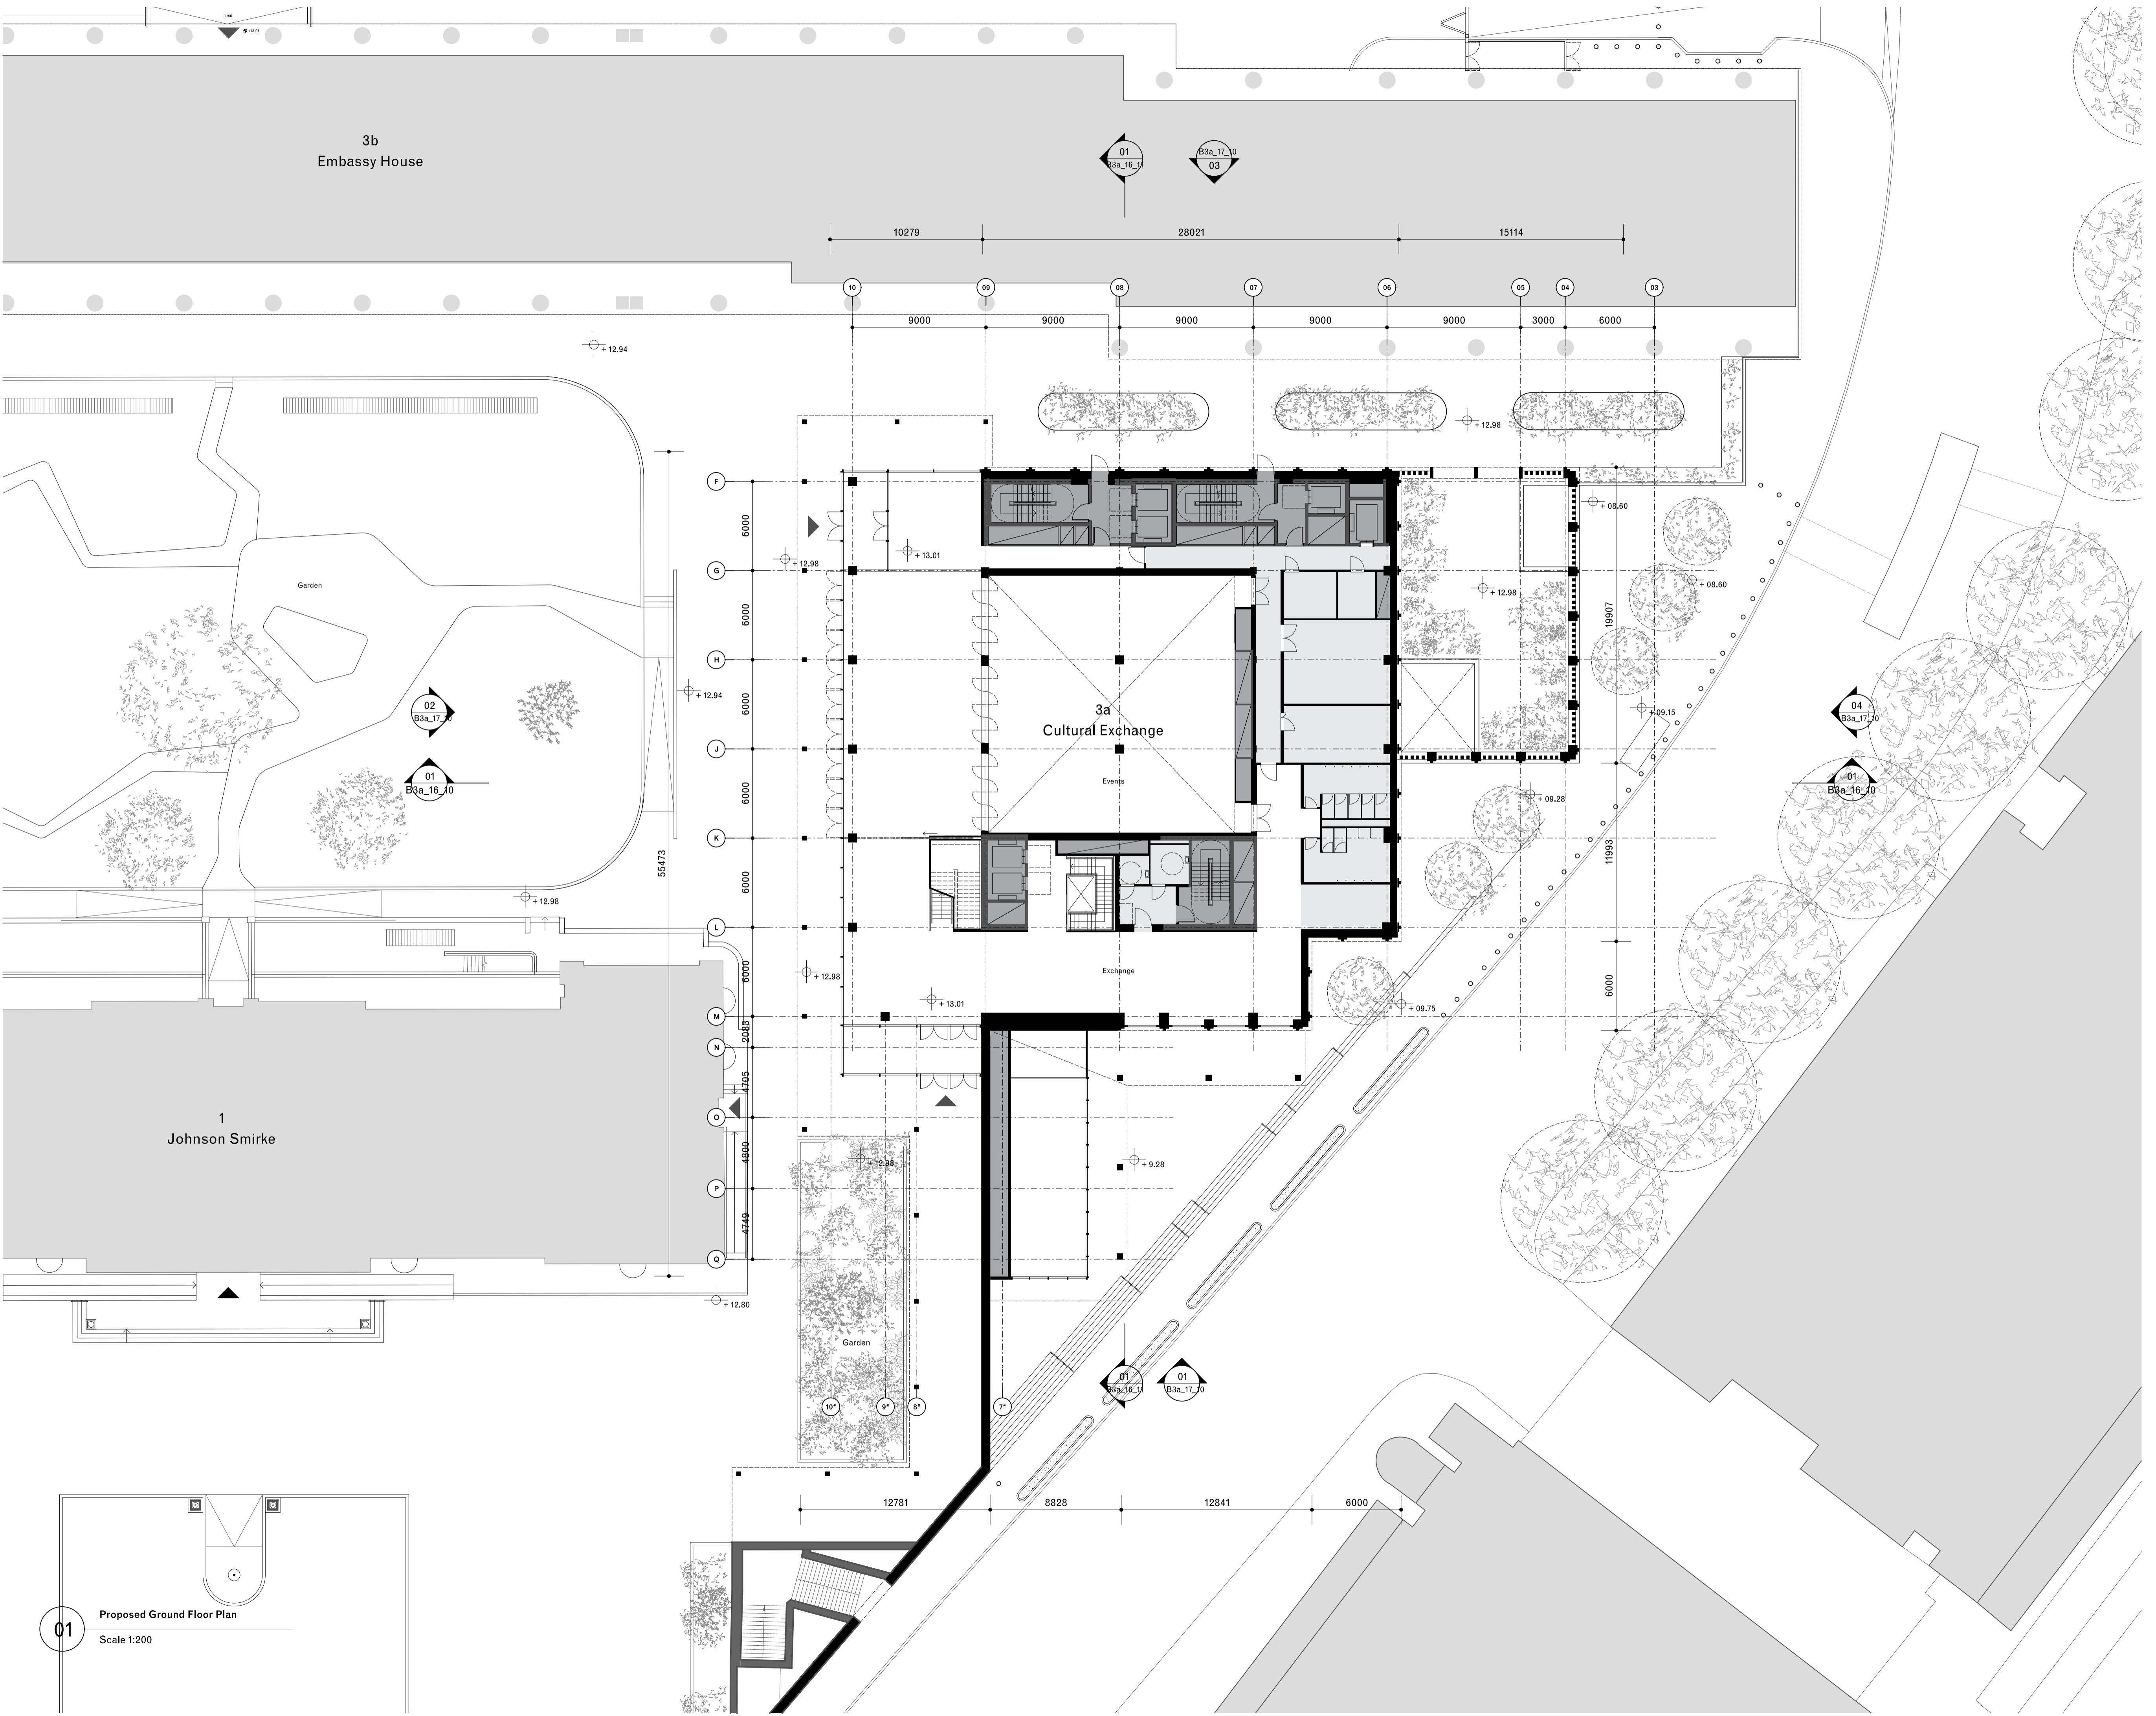

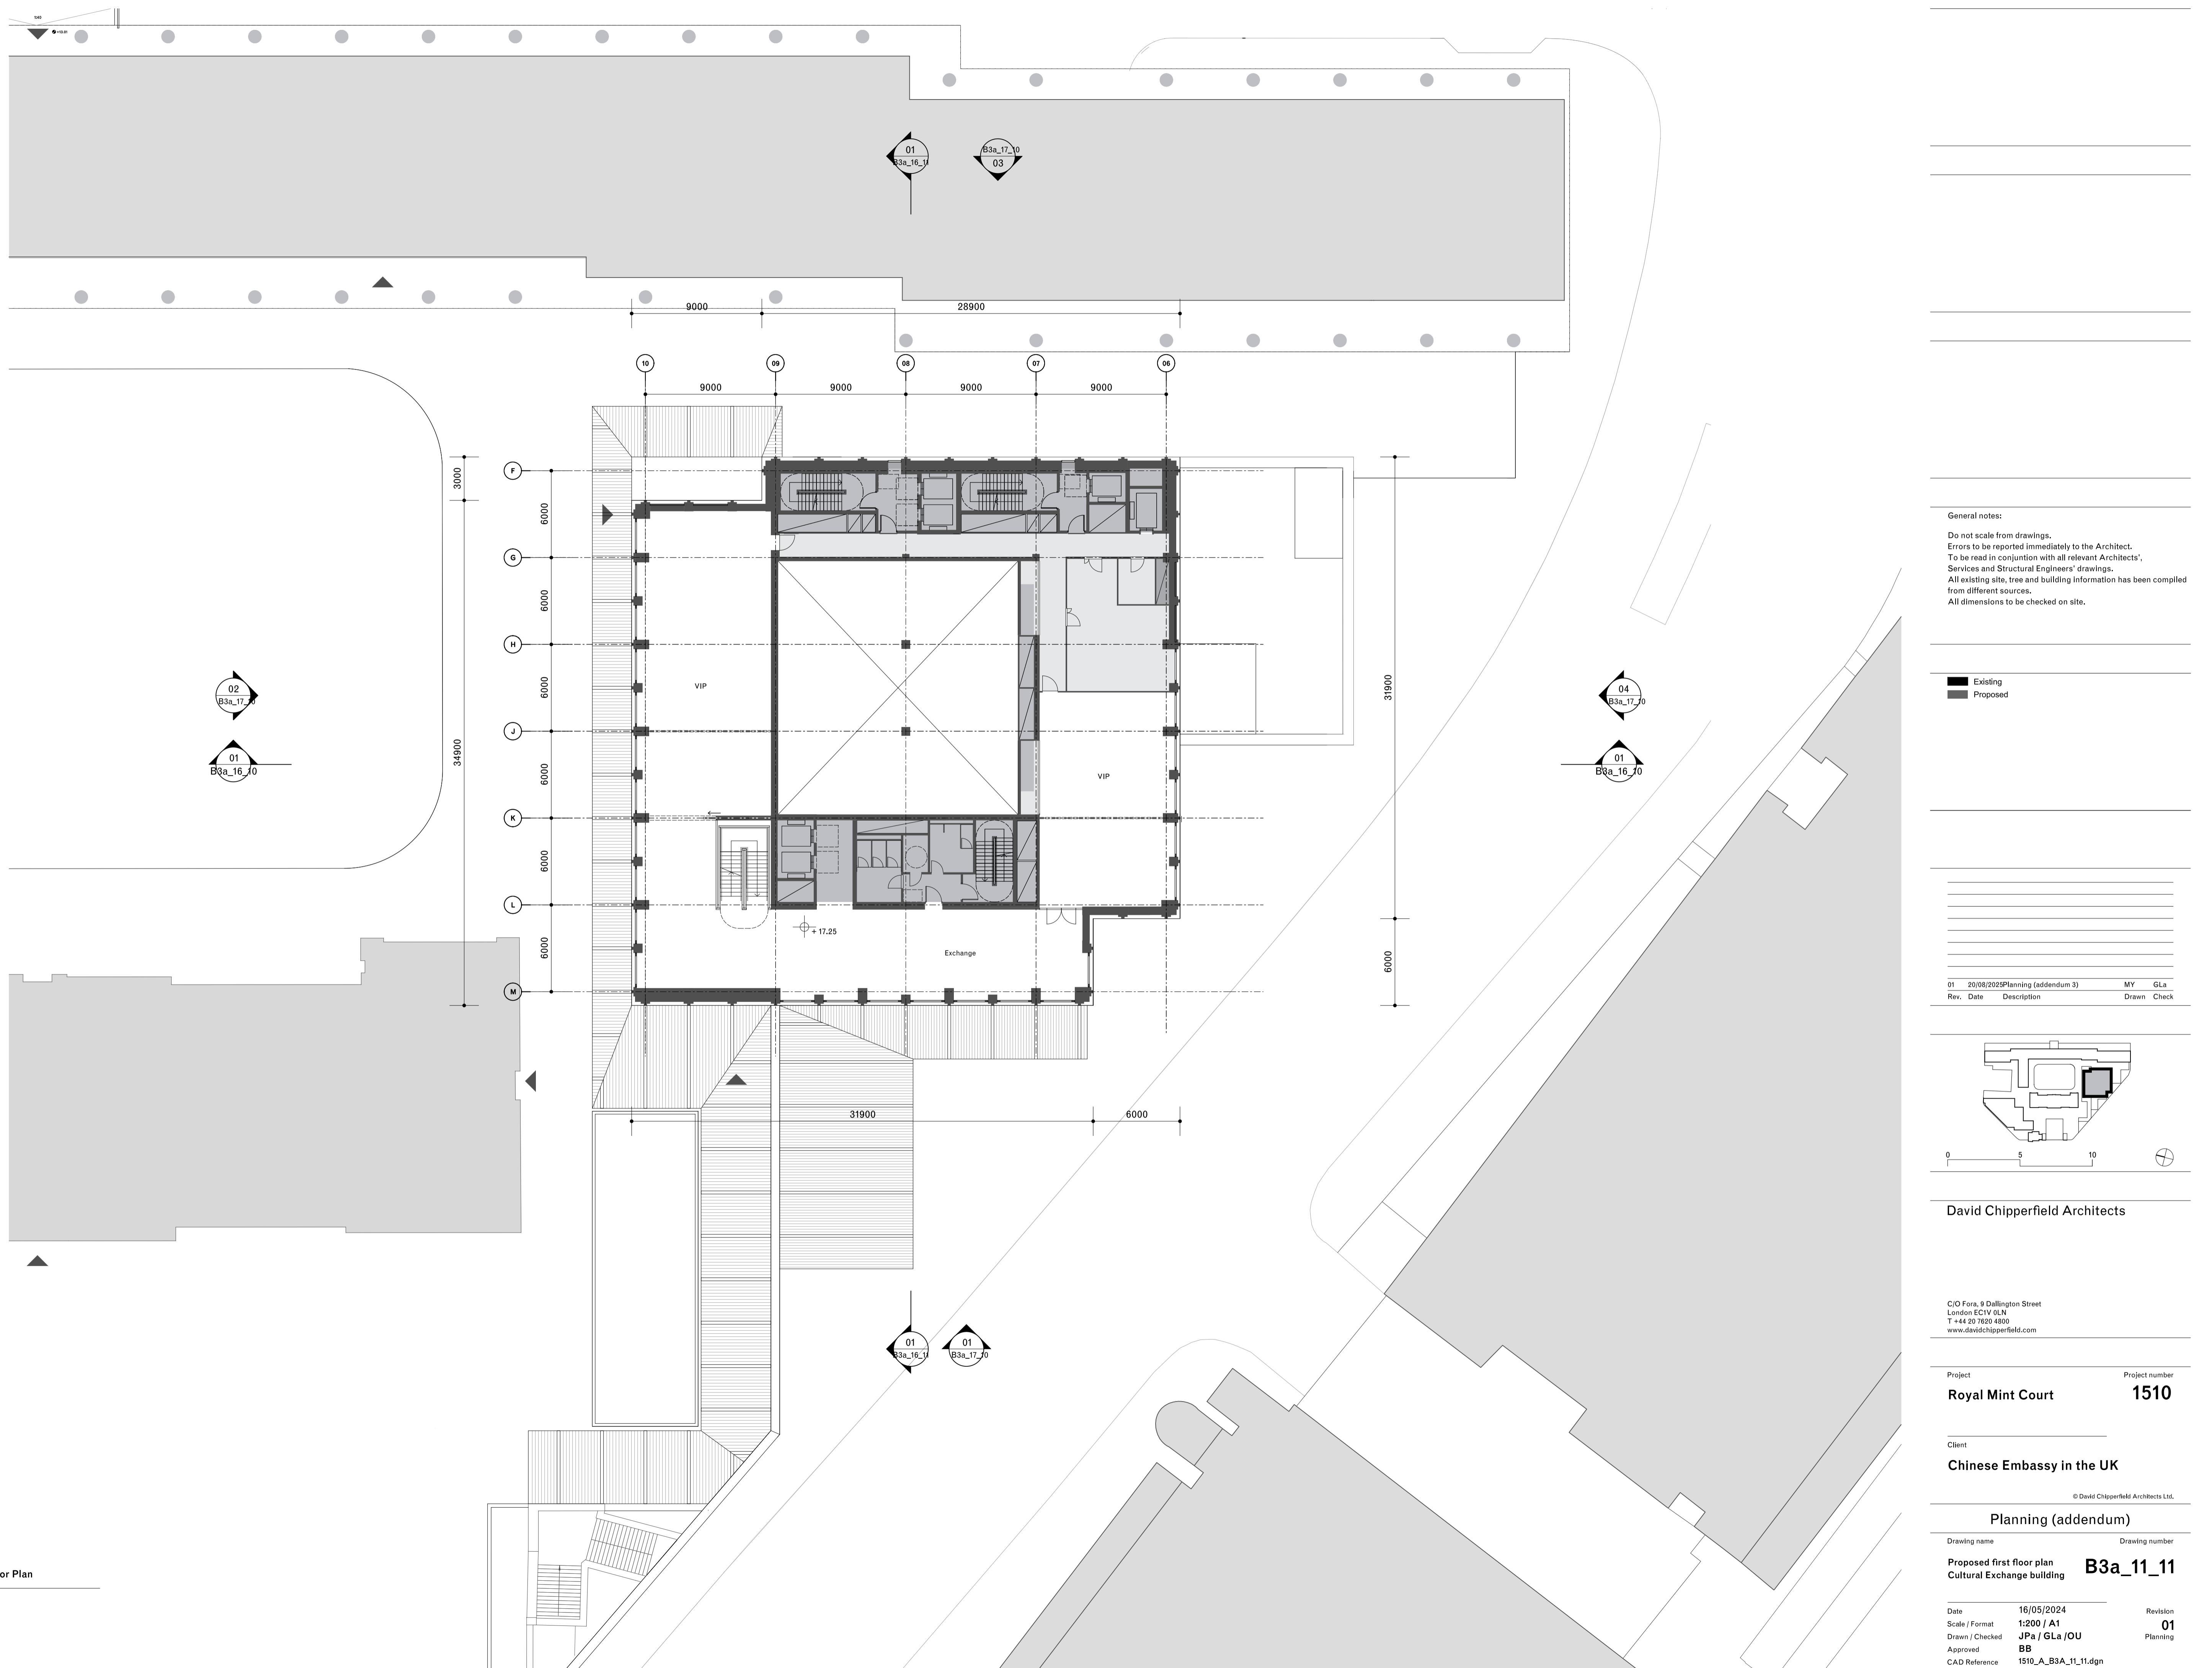

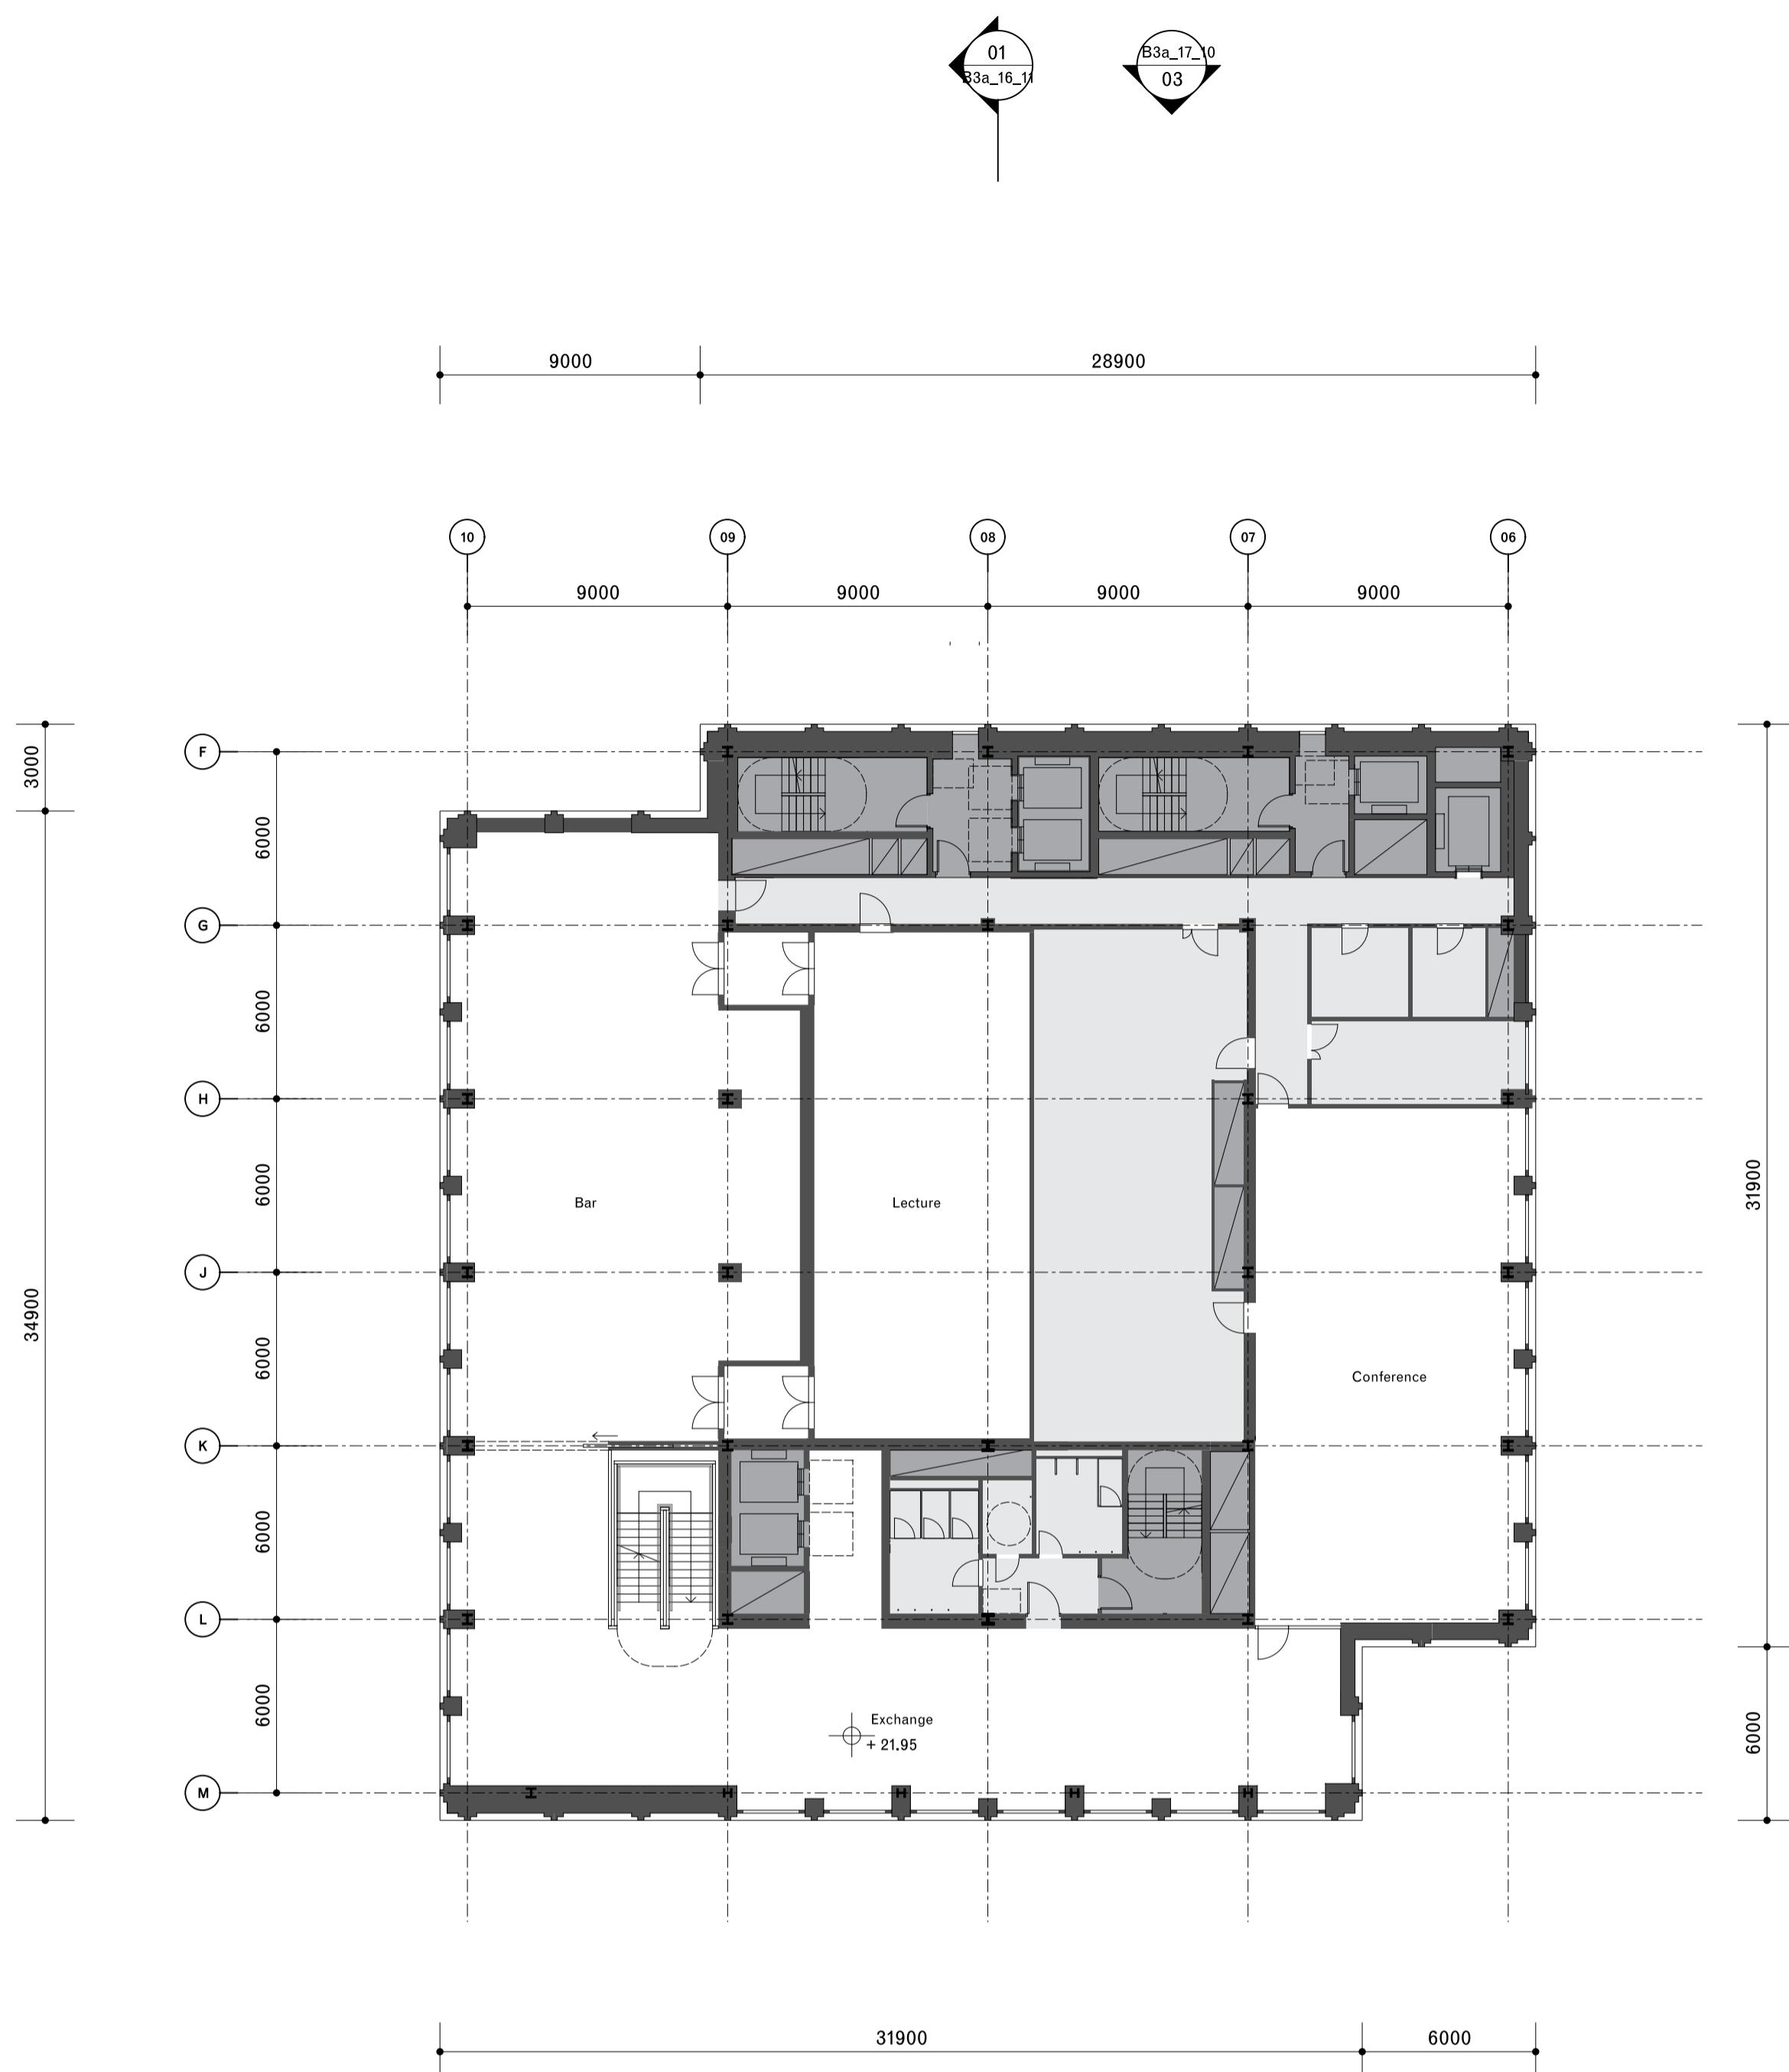


01
Proposed Second floor Plan
Scale 1:200

General notes:
Do not scale from drawings.
Errors to be reported immediately to the Architect.
To be read in conjunction with all relevant Architects',
Services and Structural Engineers' drawings.
All existing site, tree and building information has been compiled
from different sources.
All dimensions to be checked on site.

■ Existing
■ Proposed

01 20/08/2025 Planning (addendum 3) MY GLa
Rev. Date Description Drawn Check

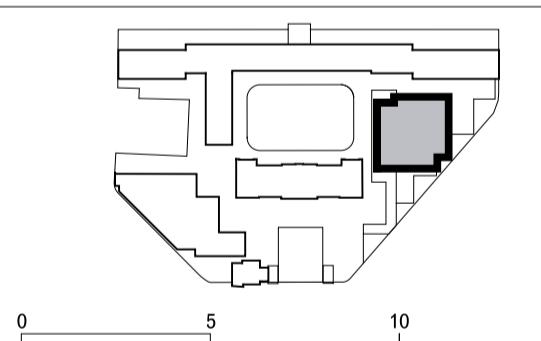

David Chipperfield Architects

C/O Fora, 9 Dillington Street
London EC1V 8LN
T +44 20 7829 4800
www.davidchipperfield.com

Project Royal Mint Court
Project number 1510


Client Chinese Embassy in the UK

© David Chipperfield Architects Ltd.


Planning (addendum)

Drawing name Proposed second floor plan
Drawing number B3a_11_12





Date 16/05/2024
Scale / Format 1:200 / A1
Drawn / Checked JPa / GLa / OU
Approved BB
CAD Reference 1510_A_B3A_11_12.dgn

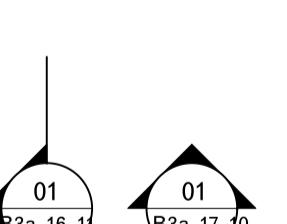

01
01

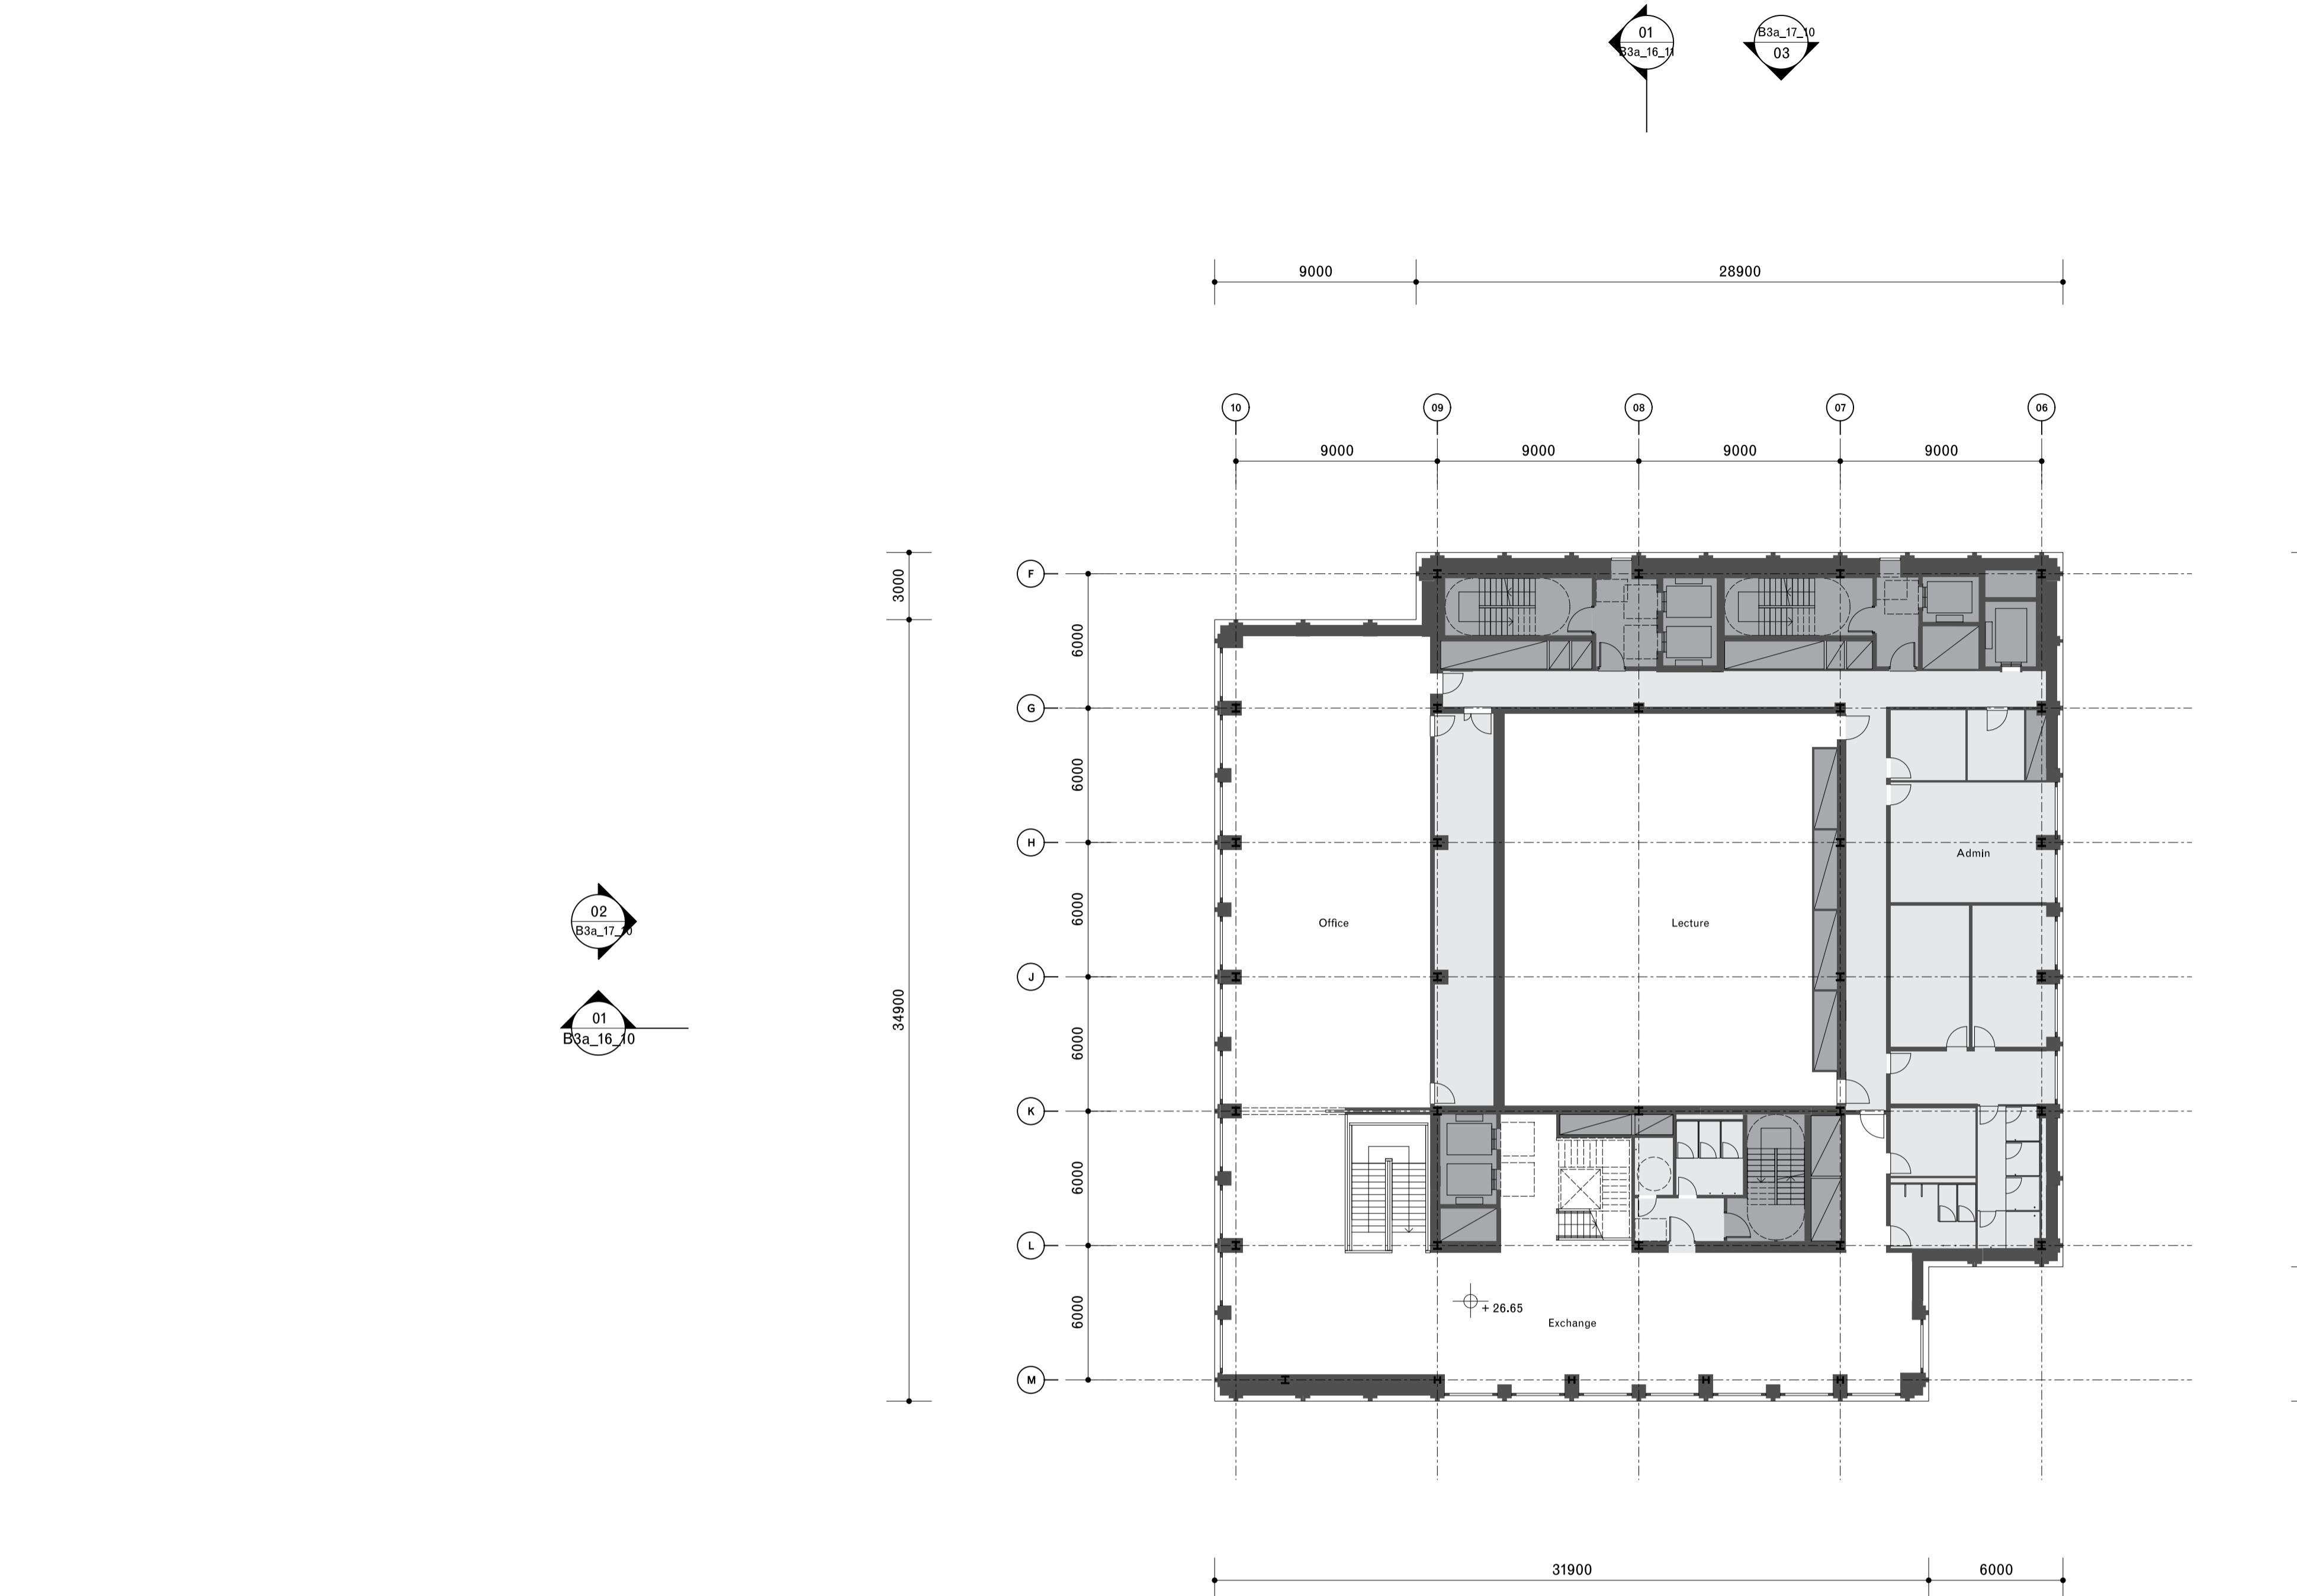


01 Proposed Third Floor Plan
Scale 1:200

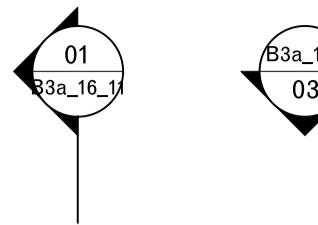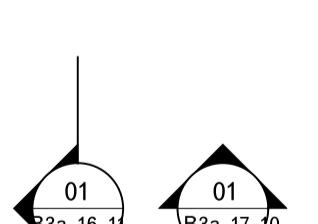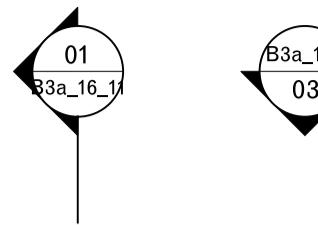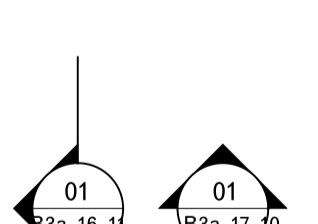

General notes:
Do not scale from drawings.
Errors to be reported immediately to the Architect.
To be read in conjunction with all relevant Architects',
Services and Structural Engineers' drawings.
All existing site, tree and building information has been compiled
from different sources.
All dimensions to be checked on site.

■ Existing
■ Proposed

01 20/08/2025 Planning (addendum 3) MY GLa
Rev. Date Description Drawn Check

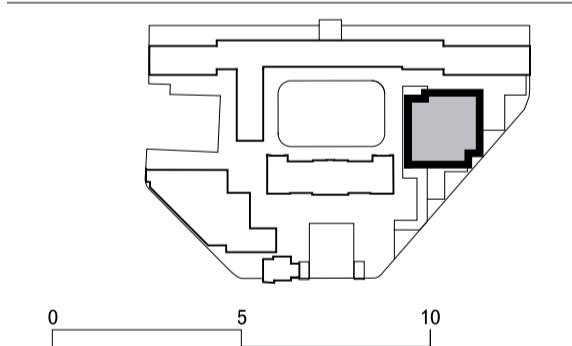

David Chipperfield Architects

C/O Fora, 9 Dillington Street
London EC1V 8LN
T +44 20 7829 4800
www.davidchipperfield.com

Project Royal Mint Court
Project number 1510

Client Chinese Embassy in the UK

© David Chipperfield Architects Ltd.


Planning (addendum)

Drawing name Proposed third floor plan
Cultural Exchange building B3a_11_13

Drawing number

Date 16/05/2024
Scale / Format 1:200 / A1
Drawn / Checked JPa / GLa
Approved BB
CAD Reference 1510_A_B3A_11_13.dgn

Revision 01
Planning

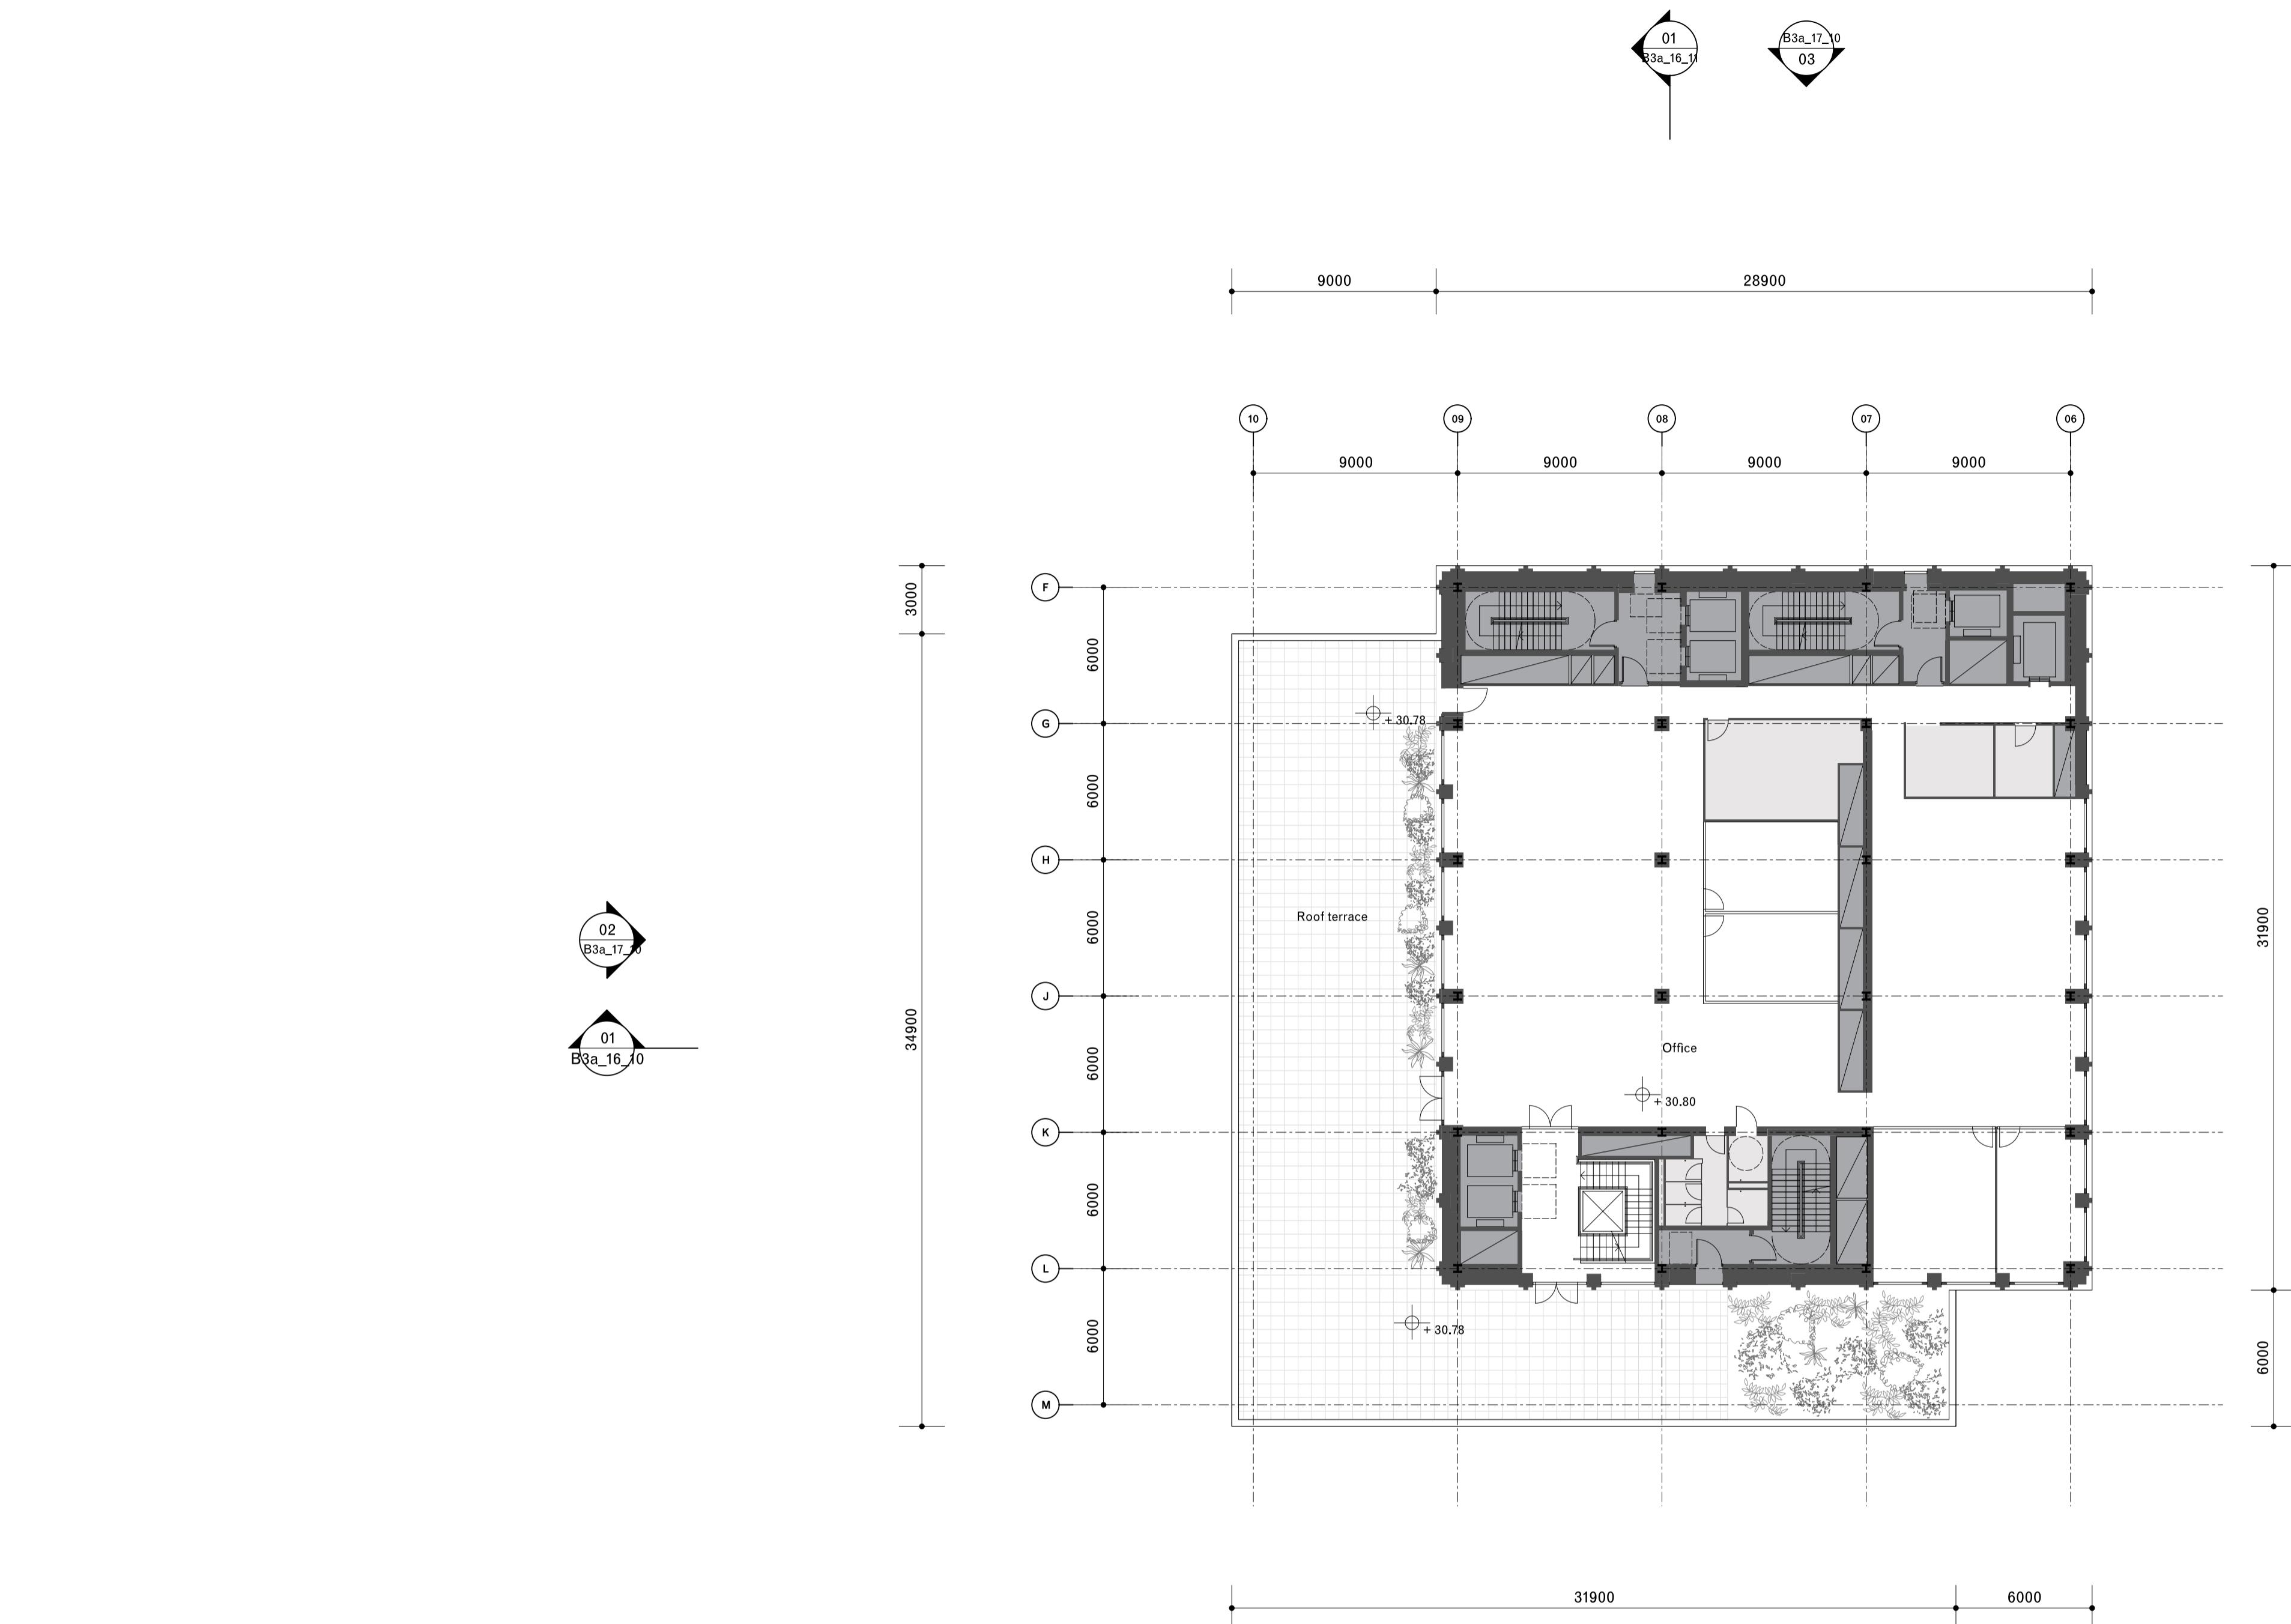


01 Proposed Forth Floor Plan
Scale 1:200

General notes:
Do not scale from drawings.
Errors to be reported immediately to the Architect.
To be read in conjunction with all relevant Architects',
Services and Structural Engineers' drawings.
All existing site, tree and building information has been compiled
from different sources.
All dimensions to be checked on site.

■ Existing
■ Proposed

01 20/08/2025 Planning (addendum 3) MY GLa
Rev. Date Description Drawn Check

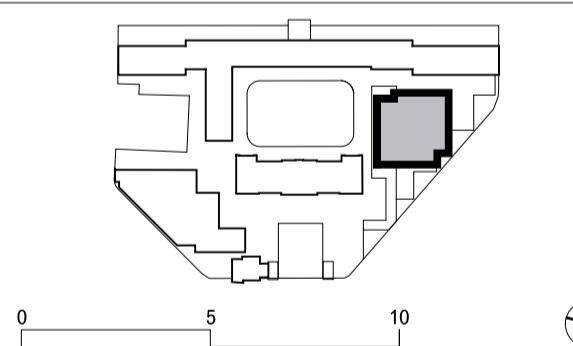

David Chipperfield Architects

C/O Fora, 9 Dillington Street
London EC1V 8LN
T +44 20 7829 4800
www.davidchipperfield.com


Project Royal Mint Court
Project number 1510

Client Chinese Embassy in the UK


Planning (addendum)

Drawing name Proposed fourth floor plan
Drawing number B3a_11_14

Date 16/05/2024
Scale / Format 1:200 / A1
Drawn / Checked JPa / GLa / OU
Approved BB
CAD Reference 1510_A_B3A_11_14.dgn

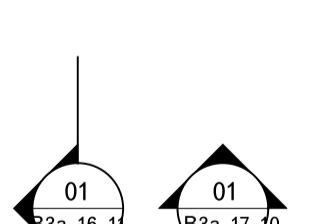

01 B3a_16_10
01 B3a_17_10

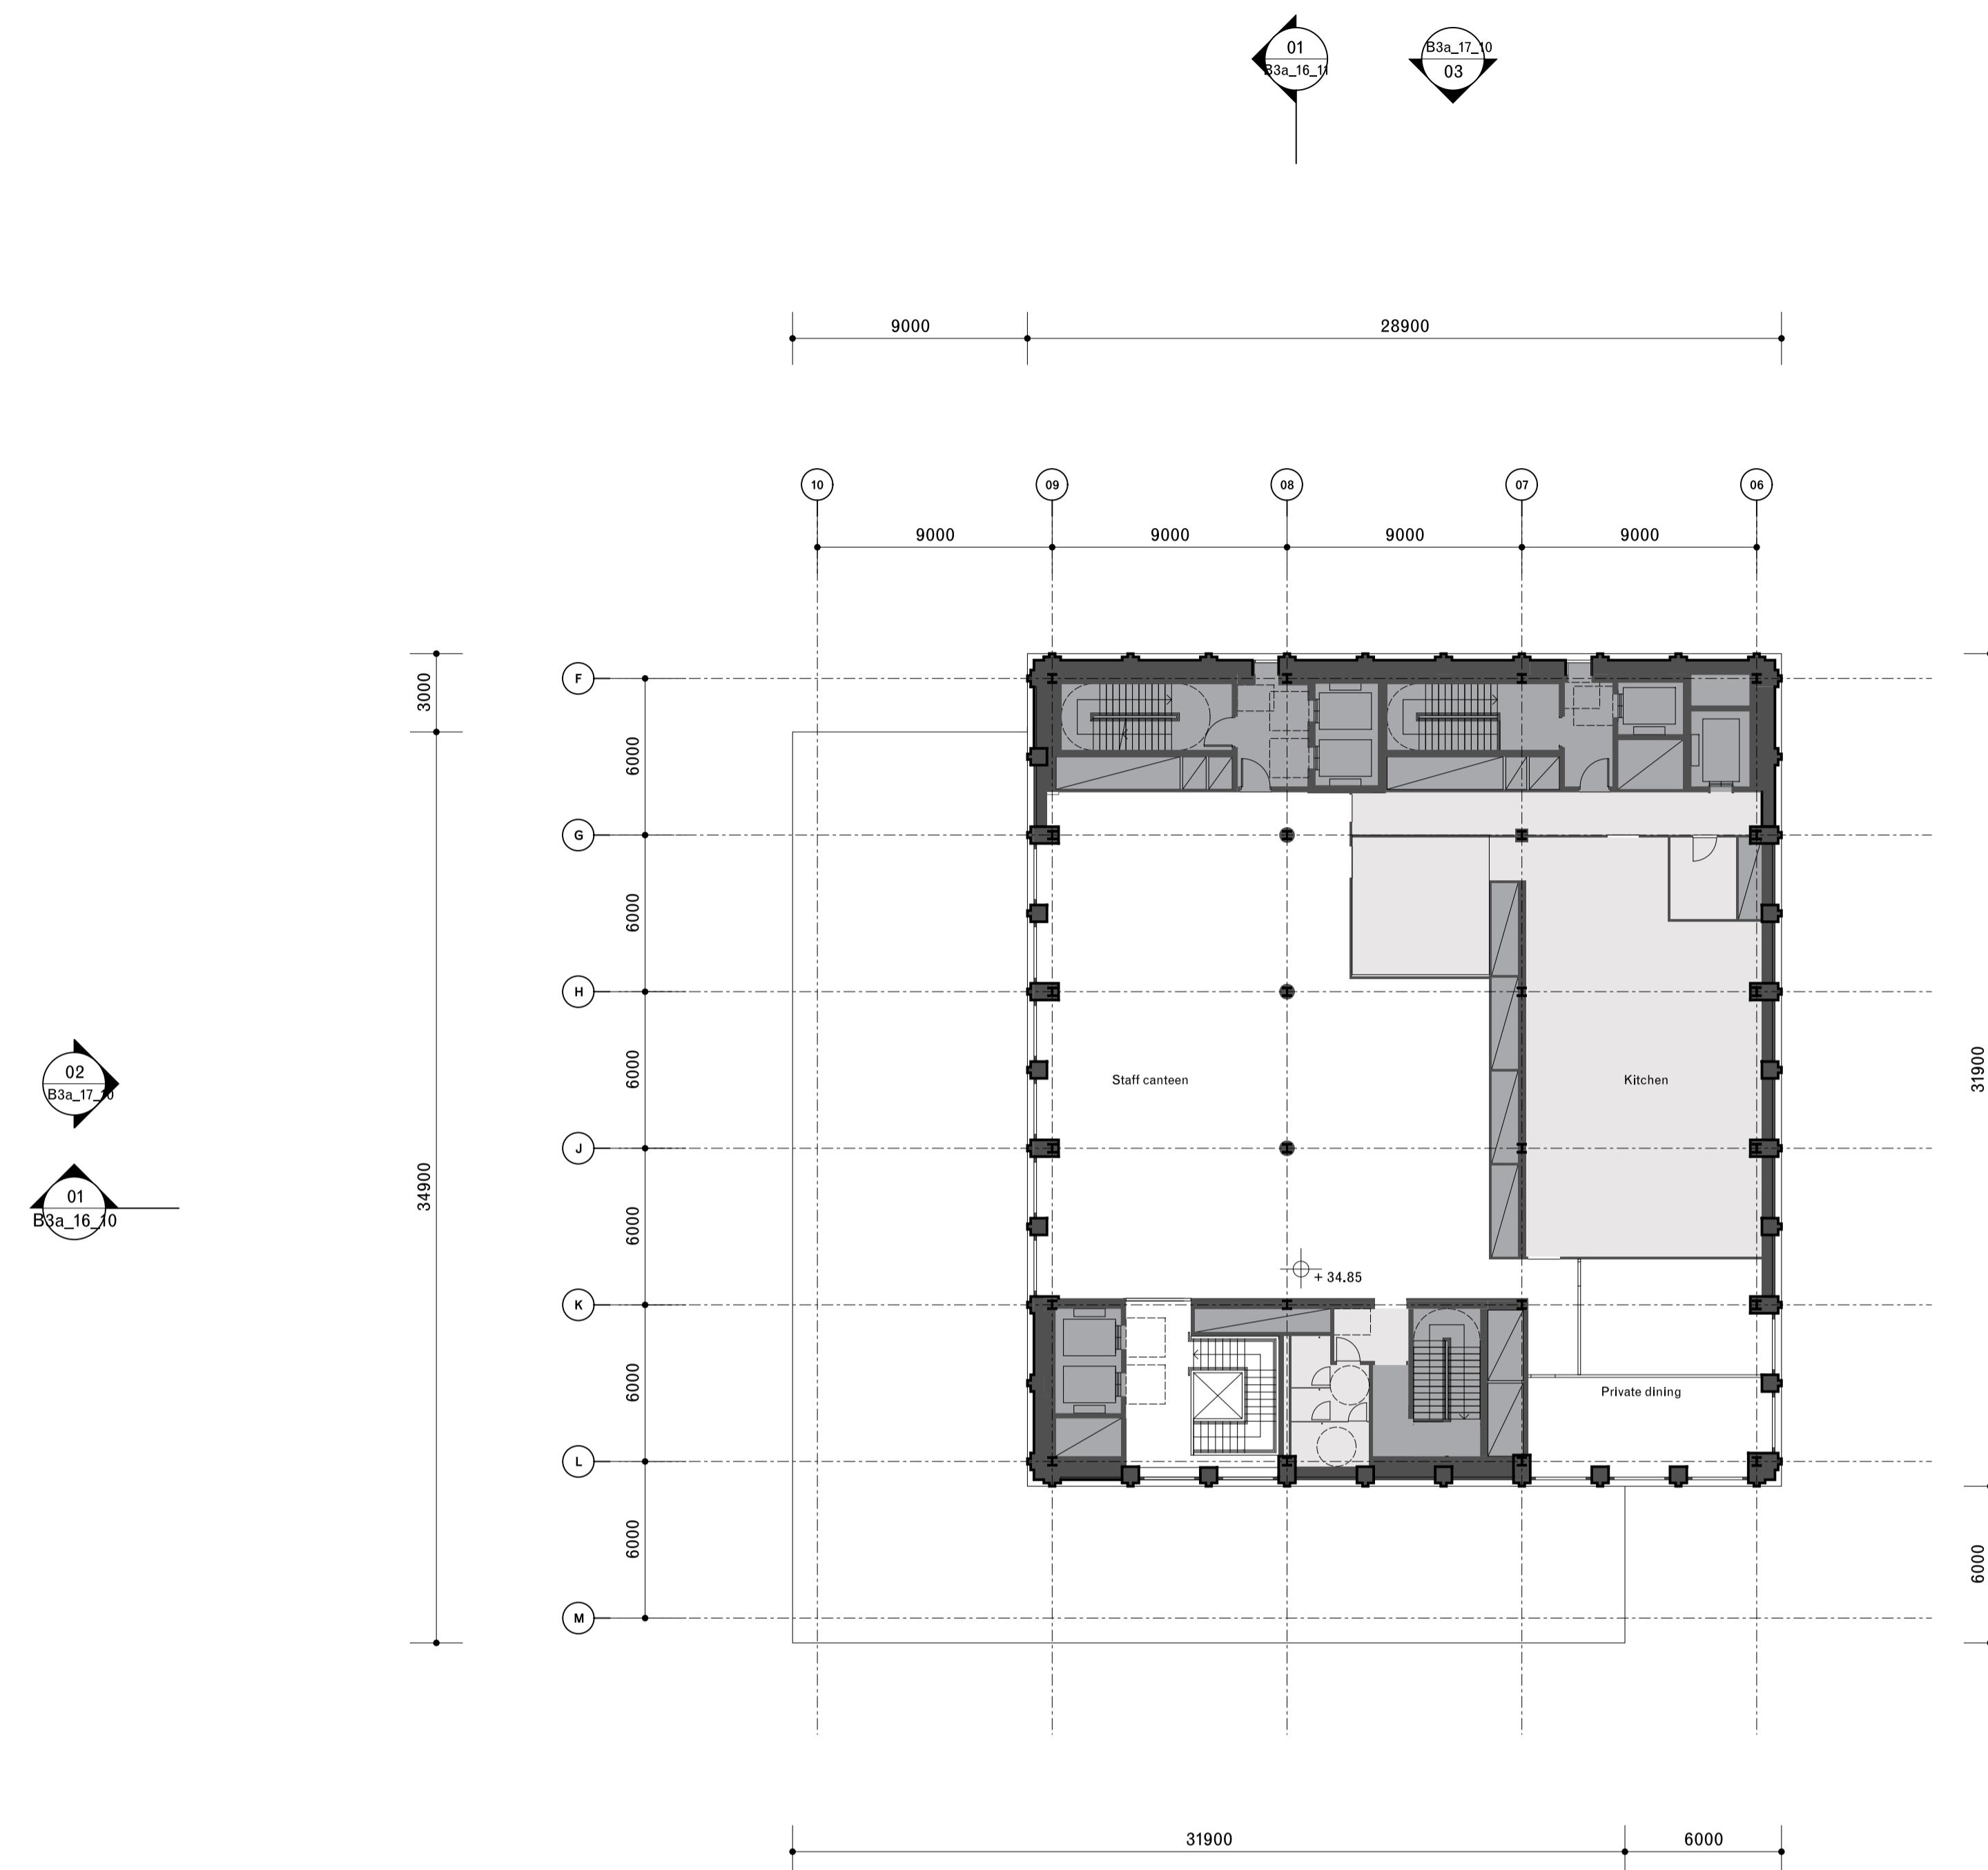


01 Proposed Fifth Floor Plan
Scale 1:200

General notes:
Do not scale from drawings.
Errors to be reported immediately to the Architect.
To be read in conjunction with all relevant Architects',
Services and Structural Engineers' drawings.
All existing site, tree and building information has been compiled
from different sources.
All dimensions to be checked on site.

■ Existing
■ Proposed

01 20/08/2025 Planning (addendum 3) MY GLa
Rev. Date Description Drawn Check

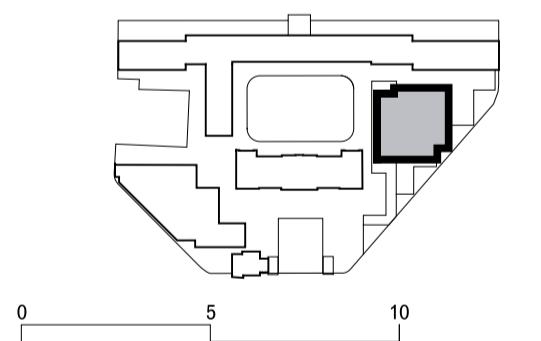

David Chipperfield Architects

C/O Fora, 9 Dillington Street
London EC1V 8LW
T +44 20 7829 4800
www.davidchipperfield.com

Project Royal Mint Court
Project number 1510

Client Chinese Embassy in the UK


© David Chipperfield Architects Ltd.

Planning (addendum)

Drawing name Proposed fifth floor plan
Cultural Exchange building B3a_11_15

Drawing number

Date	16/05/2024	Revision	01
Scale / Format	1:200 / A1	Approved	Planning
Drawn / Checked	JPa / GLa / OU	BB	
Approved	BB	CAD Reference	1510_A_B3A_11_15.dgn

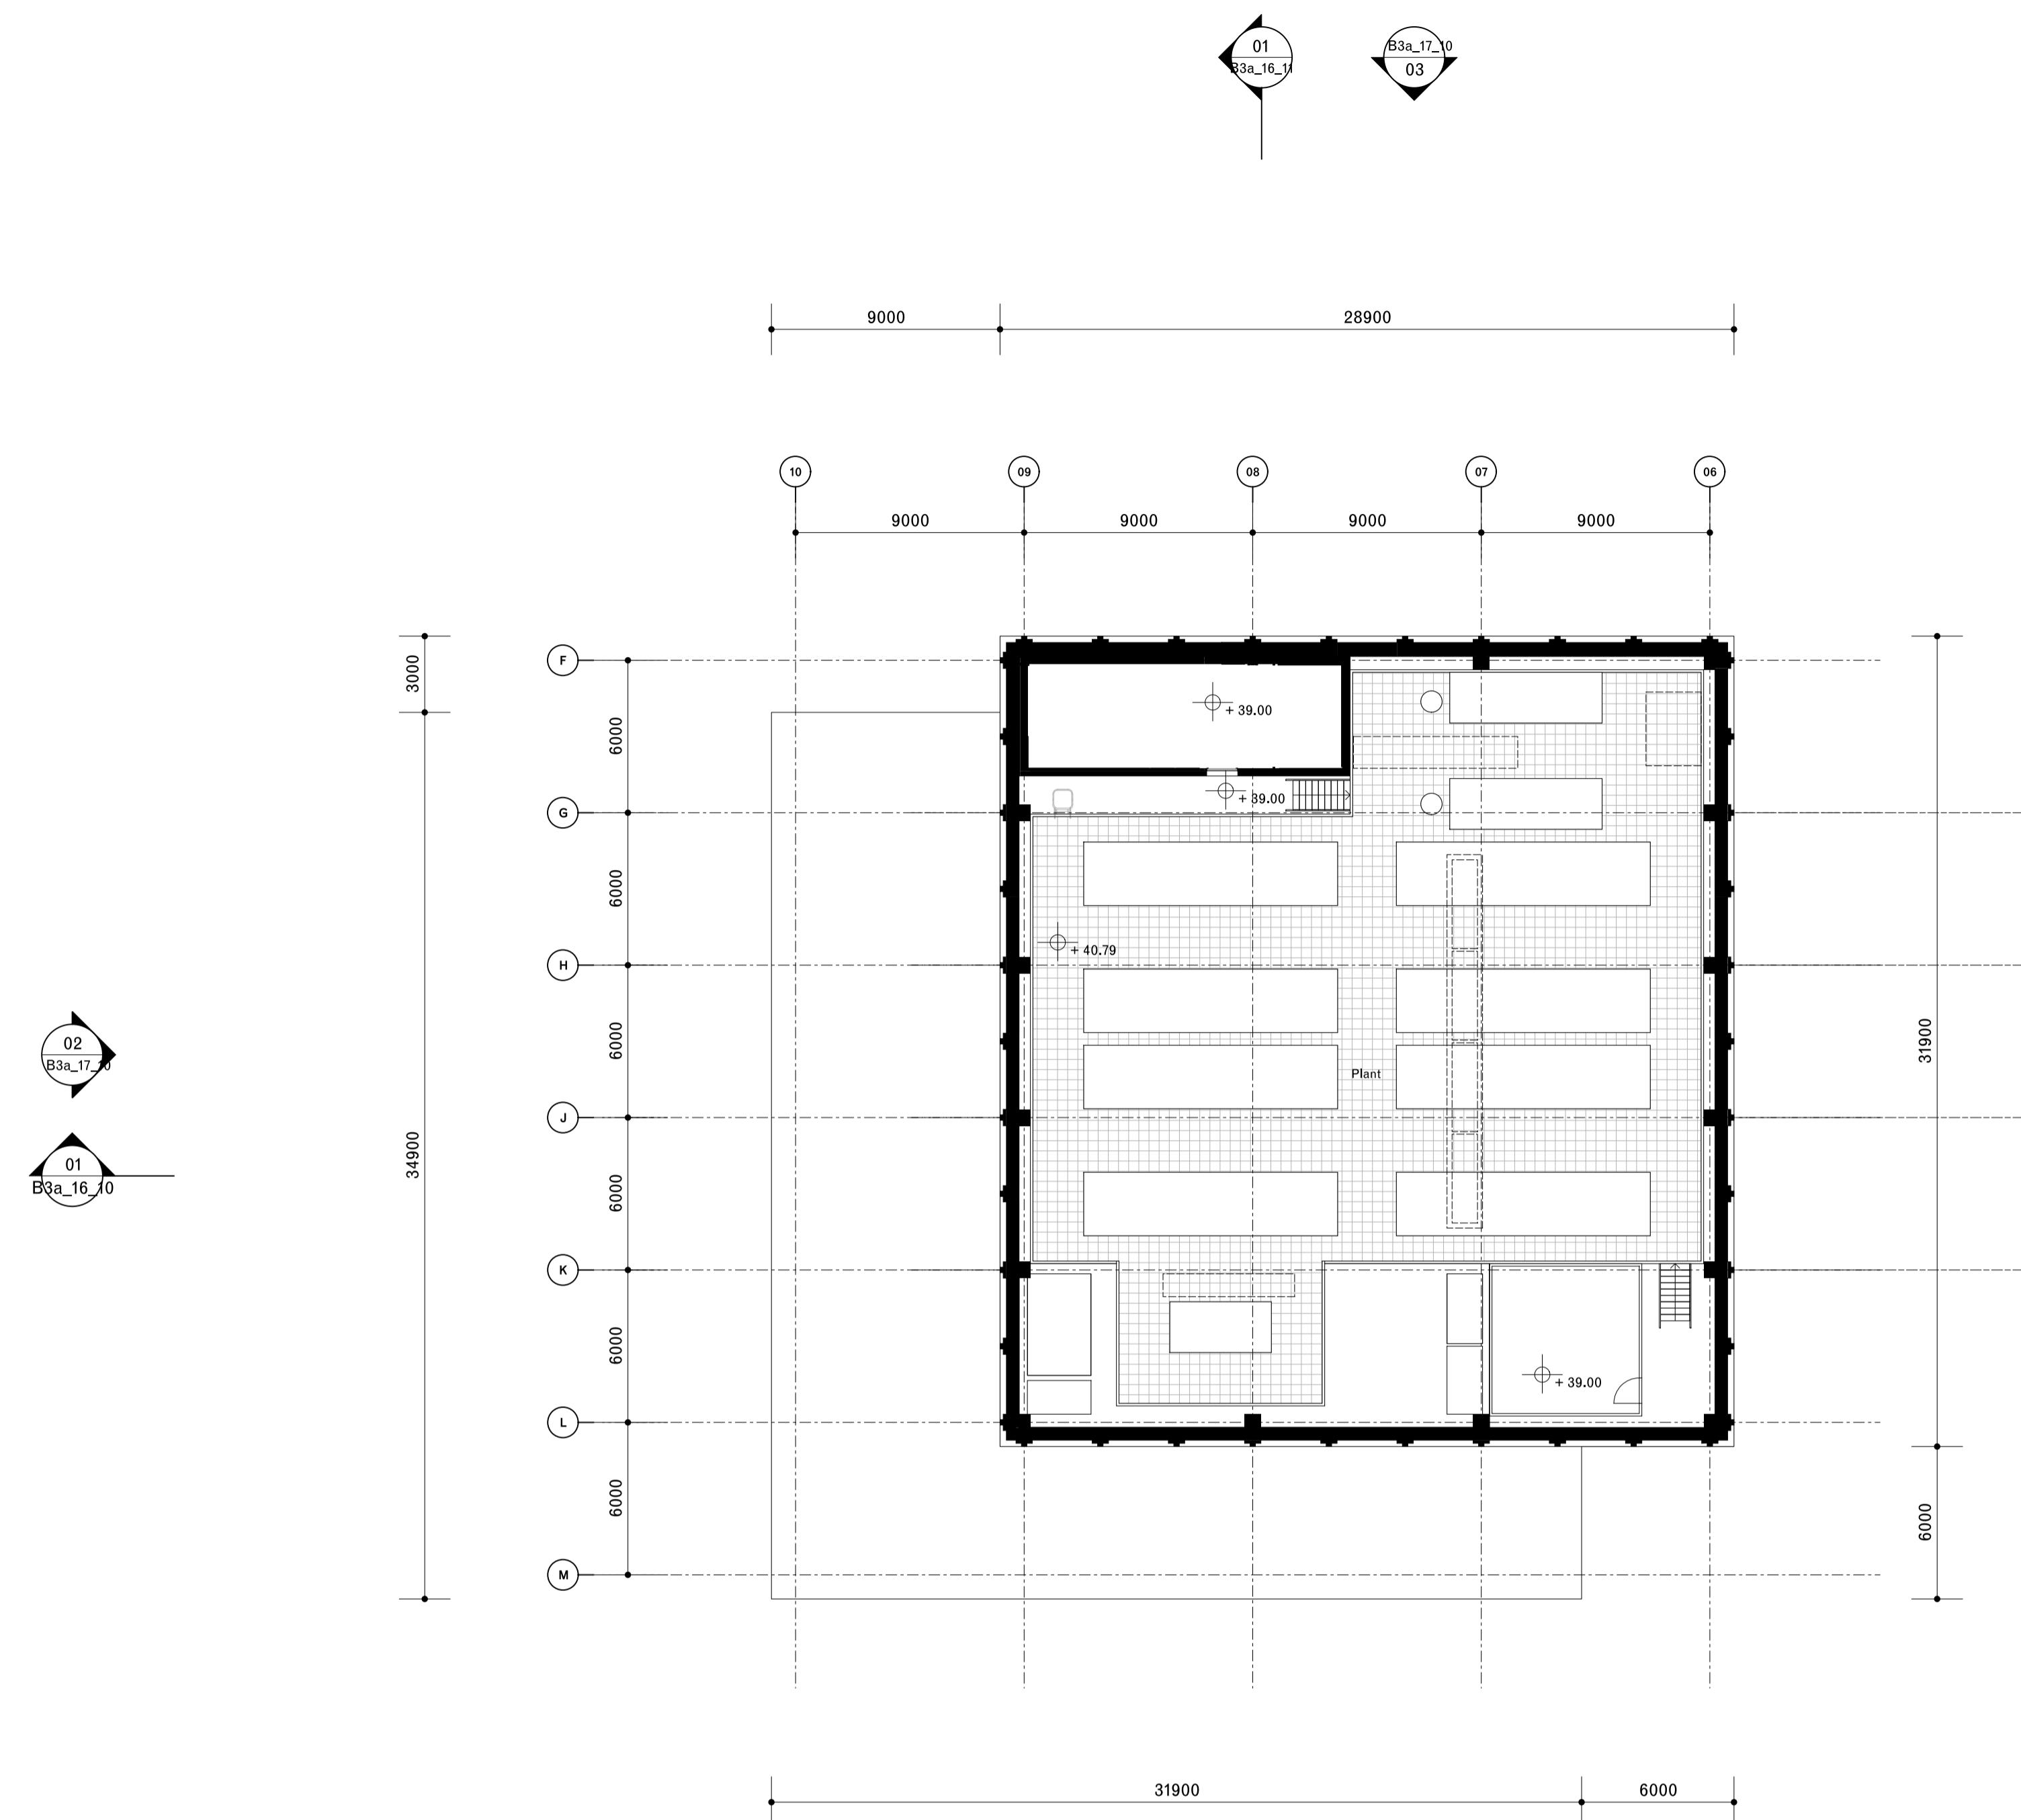

David Chipperfield Architects

C/O Fora, 9 Dallington Street
London EC1V 0LN
T +44 20 7620 4800
www.davidchipperfield.com

Project	Project number
Royal Mint Court	1510


Client

© Dava Chipperfield Architects 2018

Proposed sixth floor plan	B3a_11_16
Cultural Exchange building	
Date	16/05/2024
Scale / Format	1:200 / A1
Drawn / Checked	JPa / GLa / OU
Approved	BB
CAD Reference	1510_A_B3A_11_16.dwg

Proposed Roof Plan

Scale 1:200

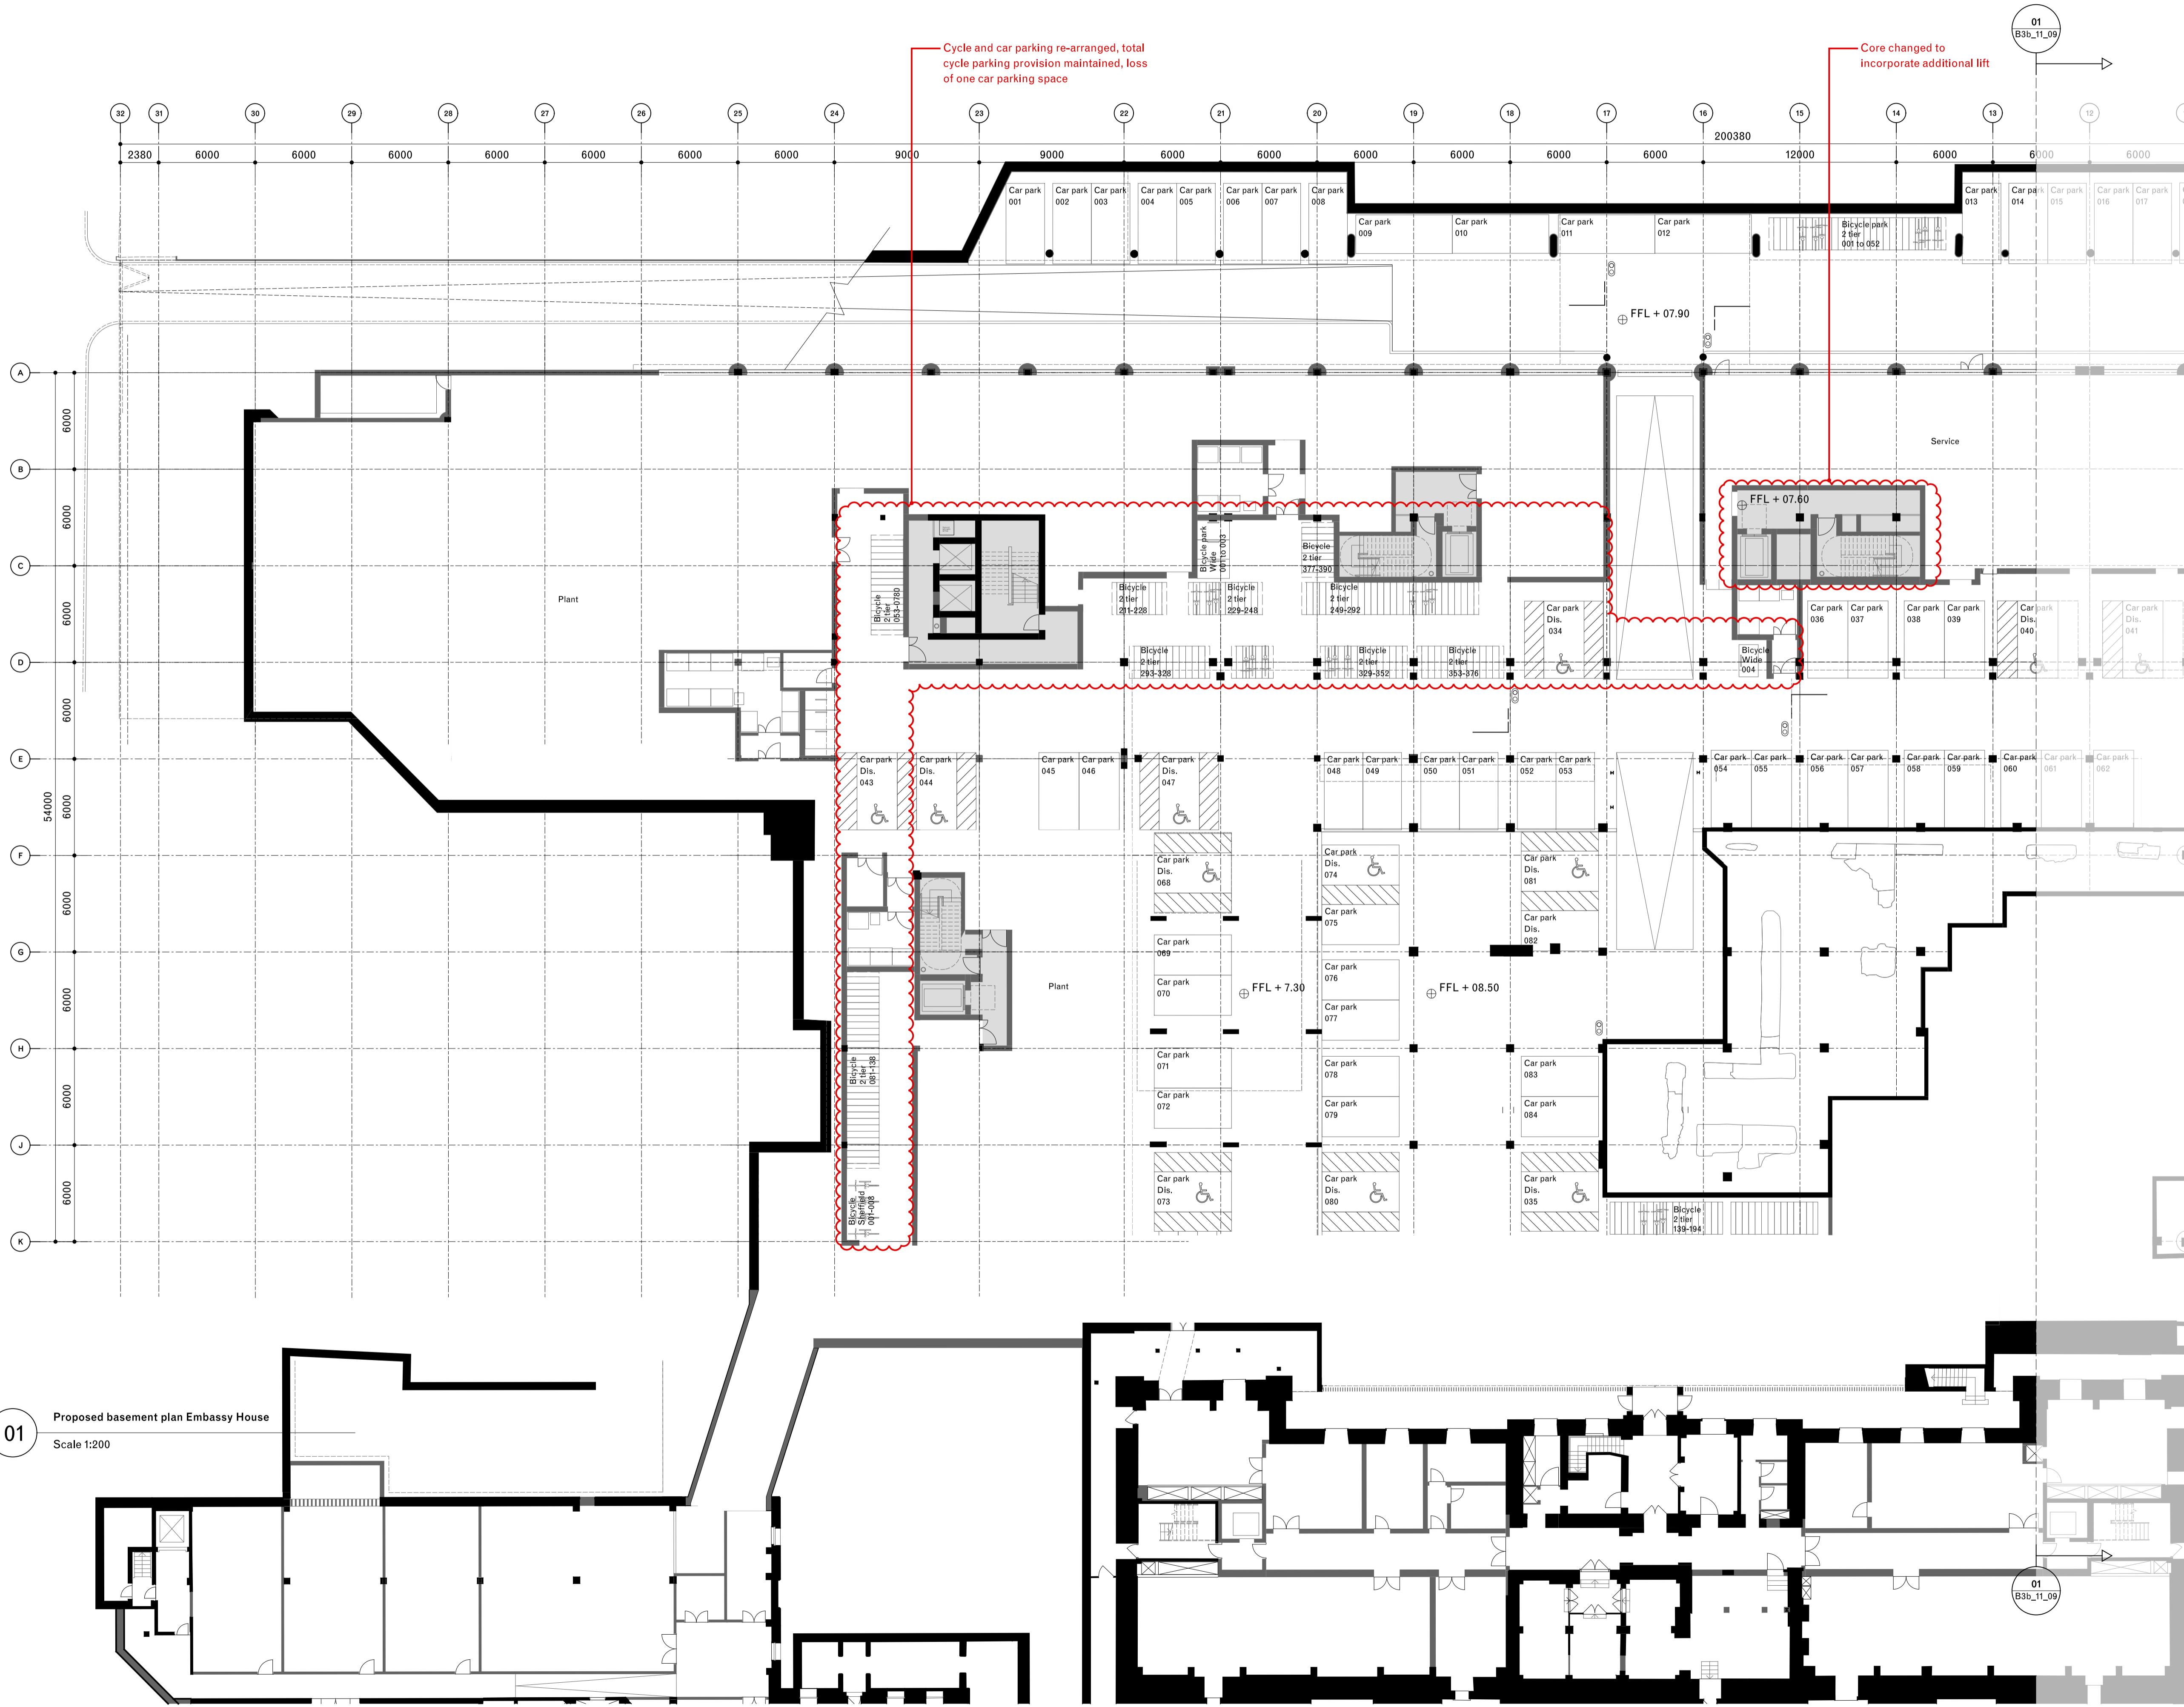

Note:
Red line shows amendments made to the original 2021 application to ensure compliance with updated legislation, including the Building Safety Act 2022 and BS9991:2024, as presented at the Planning Inquiry.

General notes:

- Do not scale from drawings.
- Errors to be reported immediately to the Architect.
- To be read in conjunction with all relevant Architects', Services and Structural Engineers' drawings.
- All existing site, tree and building information has been compiled from different sources.
- All dimensions to be checked on site.

02	20/08/2025	Planning (addendum 3)	MY	GLa
01	15/11/2024	Planning (addendum)	YZ	GLa
Rev.	Date	Description	Drawn	Checked

A grayscale micrograph showing a complex microfluidic structure. The structure consists of various interconnected channels and chambers of different sizes and shapes. A scale bar at the bottom left provides a reference for dimensions, with markings at 0, 5, and 10 micrometers. A coordinate system at the bottom right indicates the orientation of the device, with the x-axis pointing right and the z-axis pointing diagonally up and to the right.

David Chipperfield Architects

C/O Fora, 9 Dallington Street
London EC1V 0LN
T +44 20 7620 4800
www.davidchipperfield.com

Project	Project number
Royal Mint Court	1510

Client


Planning (addendum)

Drawing name Drawing number
Proposed basement plan **Ref. 14-02**

Embassy House
North, sheet 1 of 2

Date 16/05/2024 Revision
Scale / Format 1:200 / A1 02

Approved **BB**
CAD Reference 1510_A_B3b_11_08.dgn

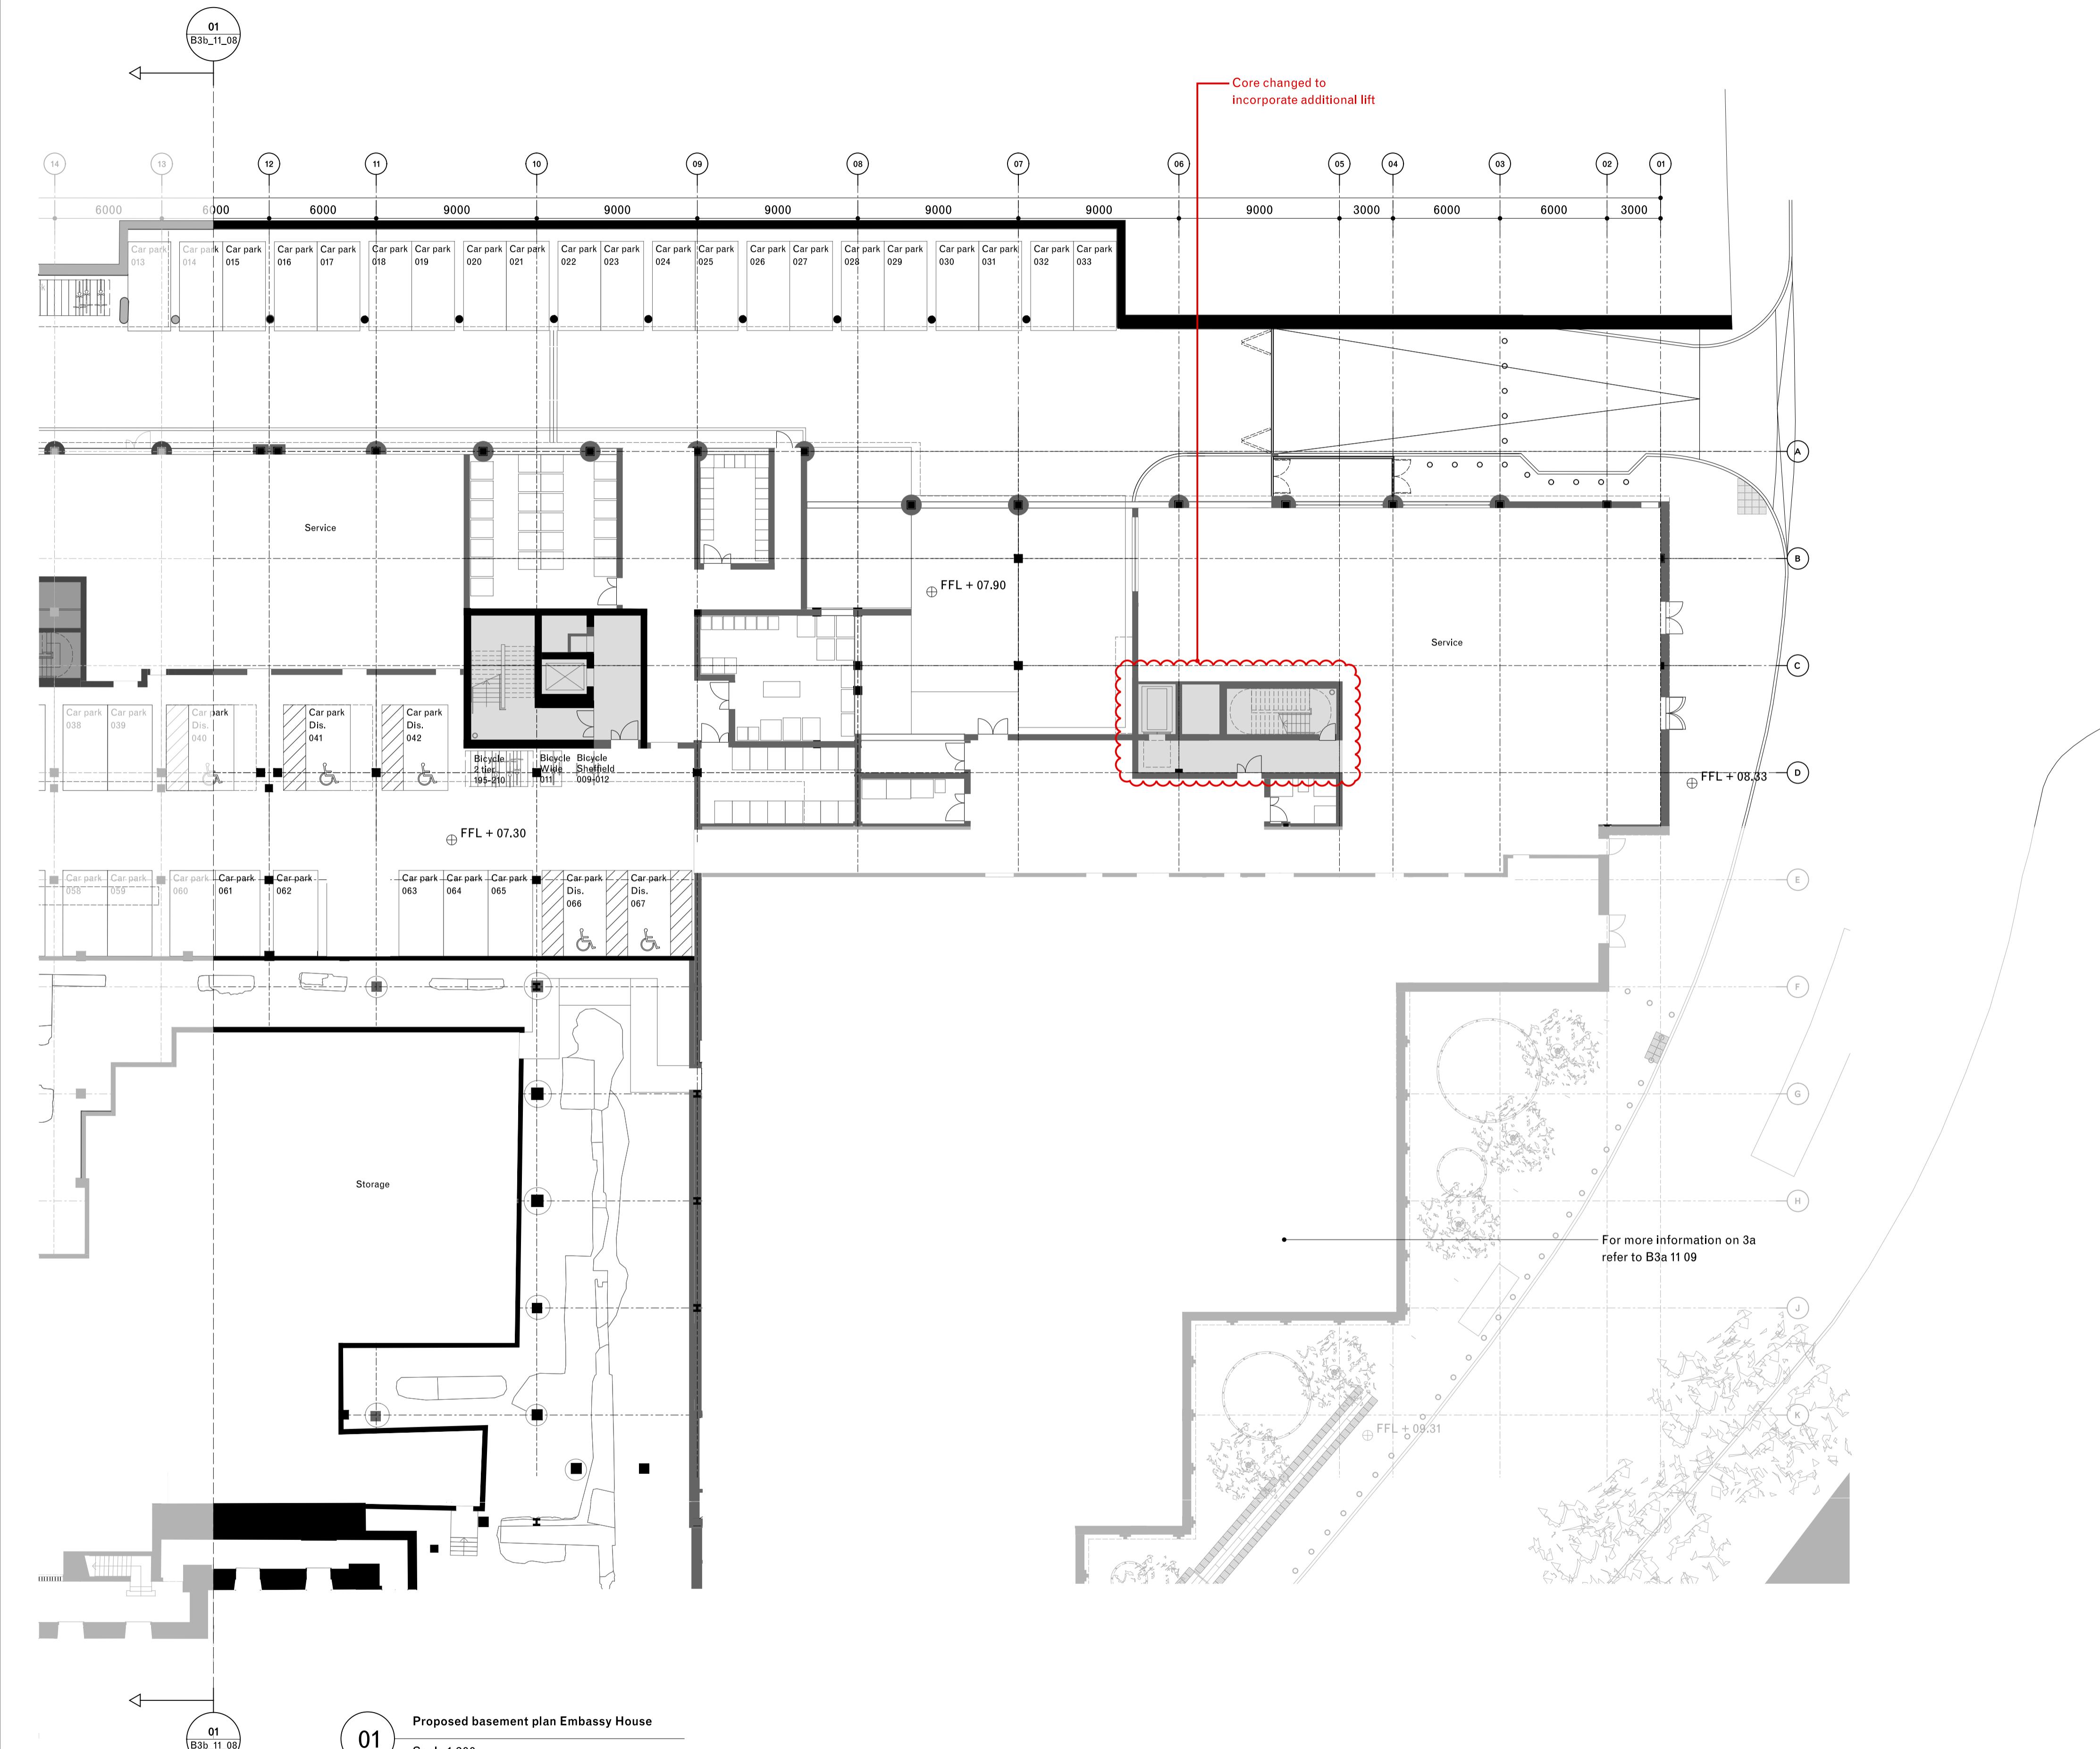


Note:
Red line shows amendments made to the original 2021 application to ensure compliance with updated legislation, including the Building Safety Act 2022 and BS9991:2024, as presented at the Planning Inquiry.

General notes:
Do not scale from drawings.
Errors to be reported immediately to the Architect.
To be read in conjunction with all relevant Architects',
Services and Structural Engineers' drawings.
All existing site, tree and building information has been compiled
from different sources.
All dimensions to be checked on site.

Existing
Proposed

02 20/08/2025 Planning (addendum 3) MY GLA
01 15/11/2024 Planning (addendum) YZ GLA
Rev. Date Description Drawn Check

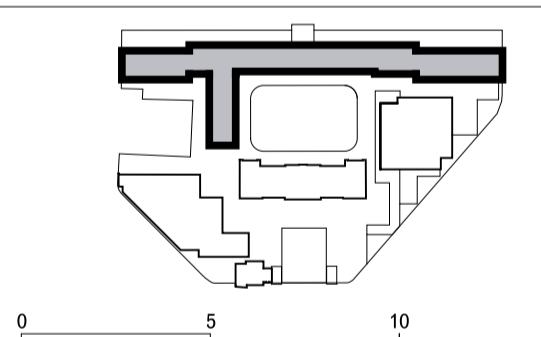


David Chipperfield Architects


C/O Fora, 9 Dillington Street
London EC1W 8LY
T +44 20 7829 4800
www.davidchipperfield.com

Project Royal Mint Court
Project number 1510

Client Chinese Embassy in the UK

Planning (addendum)
Drawing name Proposed basement plan
Drawing number Embassy House
South, sheet 2 of 2
Date 16/05/2024
Scale / Format 1:200 / A1
Drawn / Checked RPI / OU, GLA
Approved BB
CAD Reference 1510_A_B3b_11_09.dgn
Revision 02
Planning

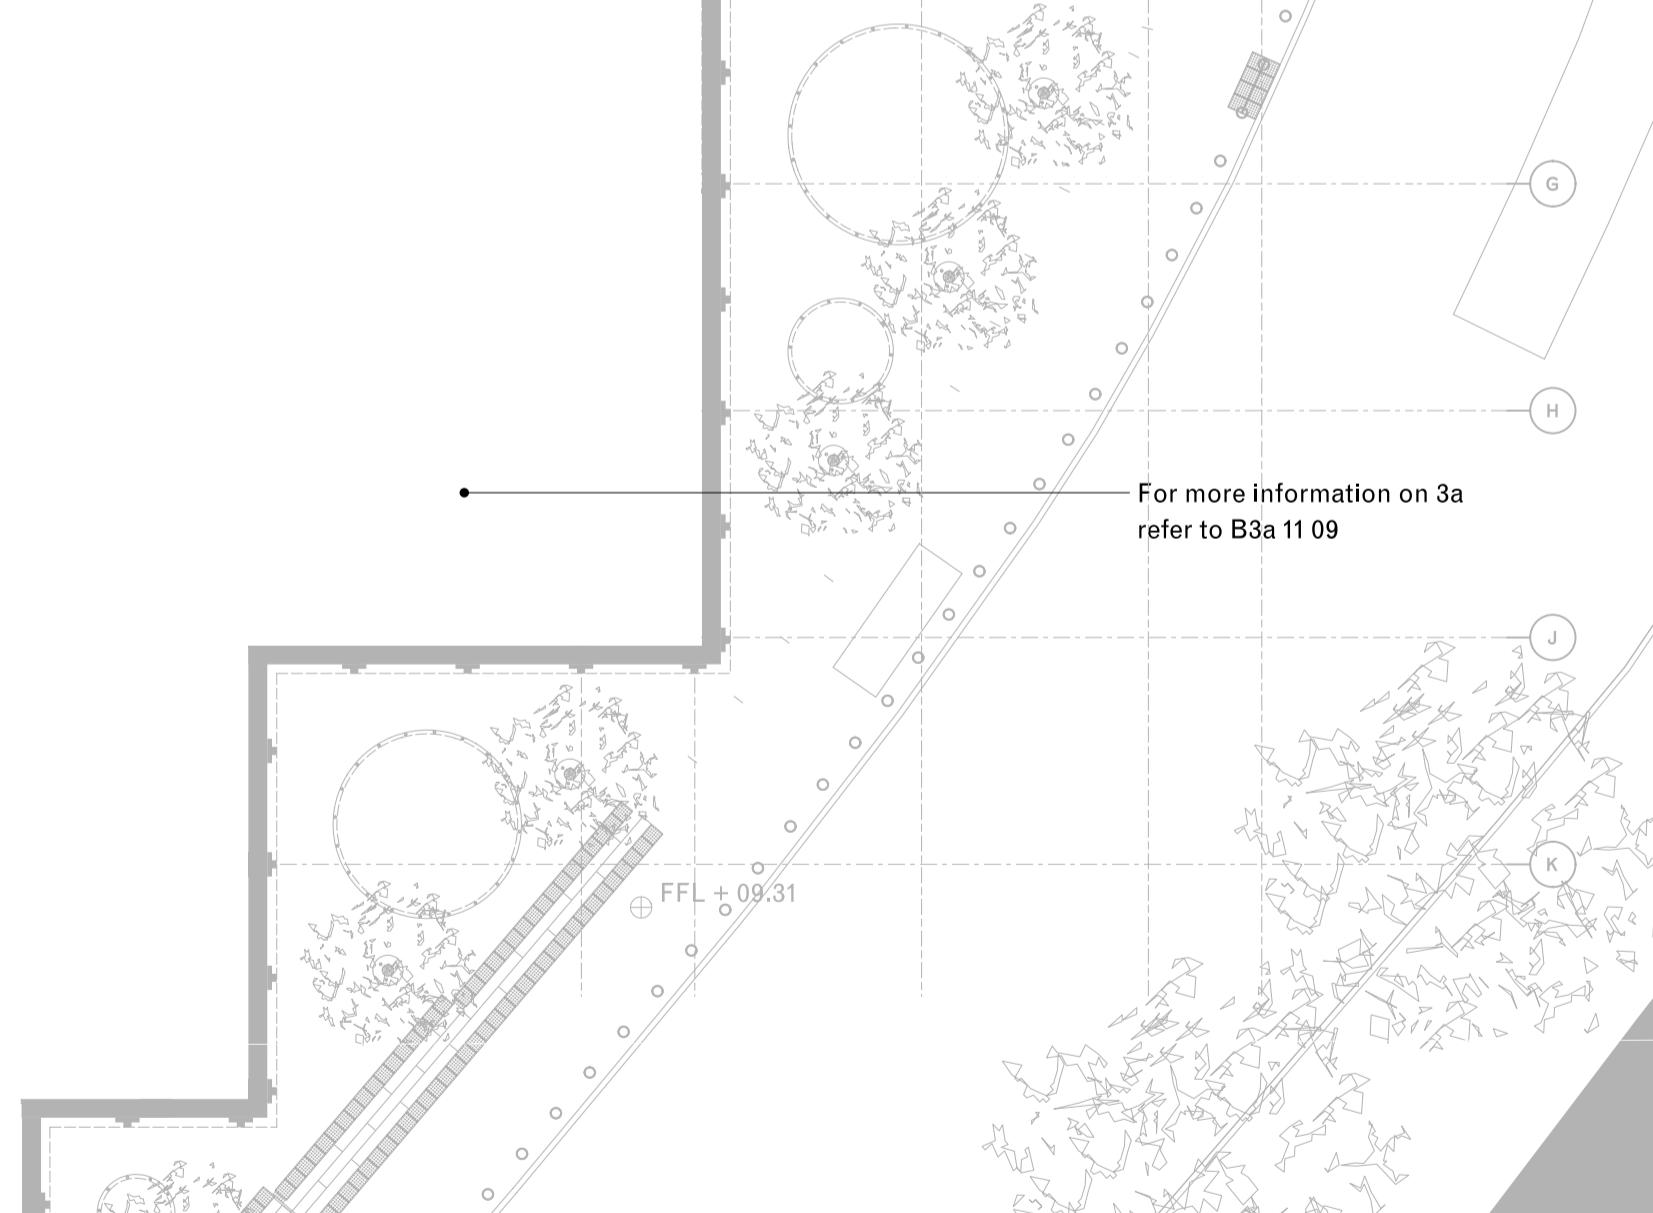


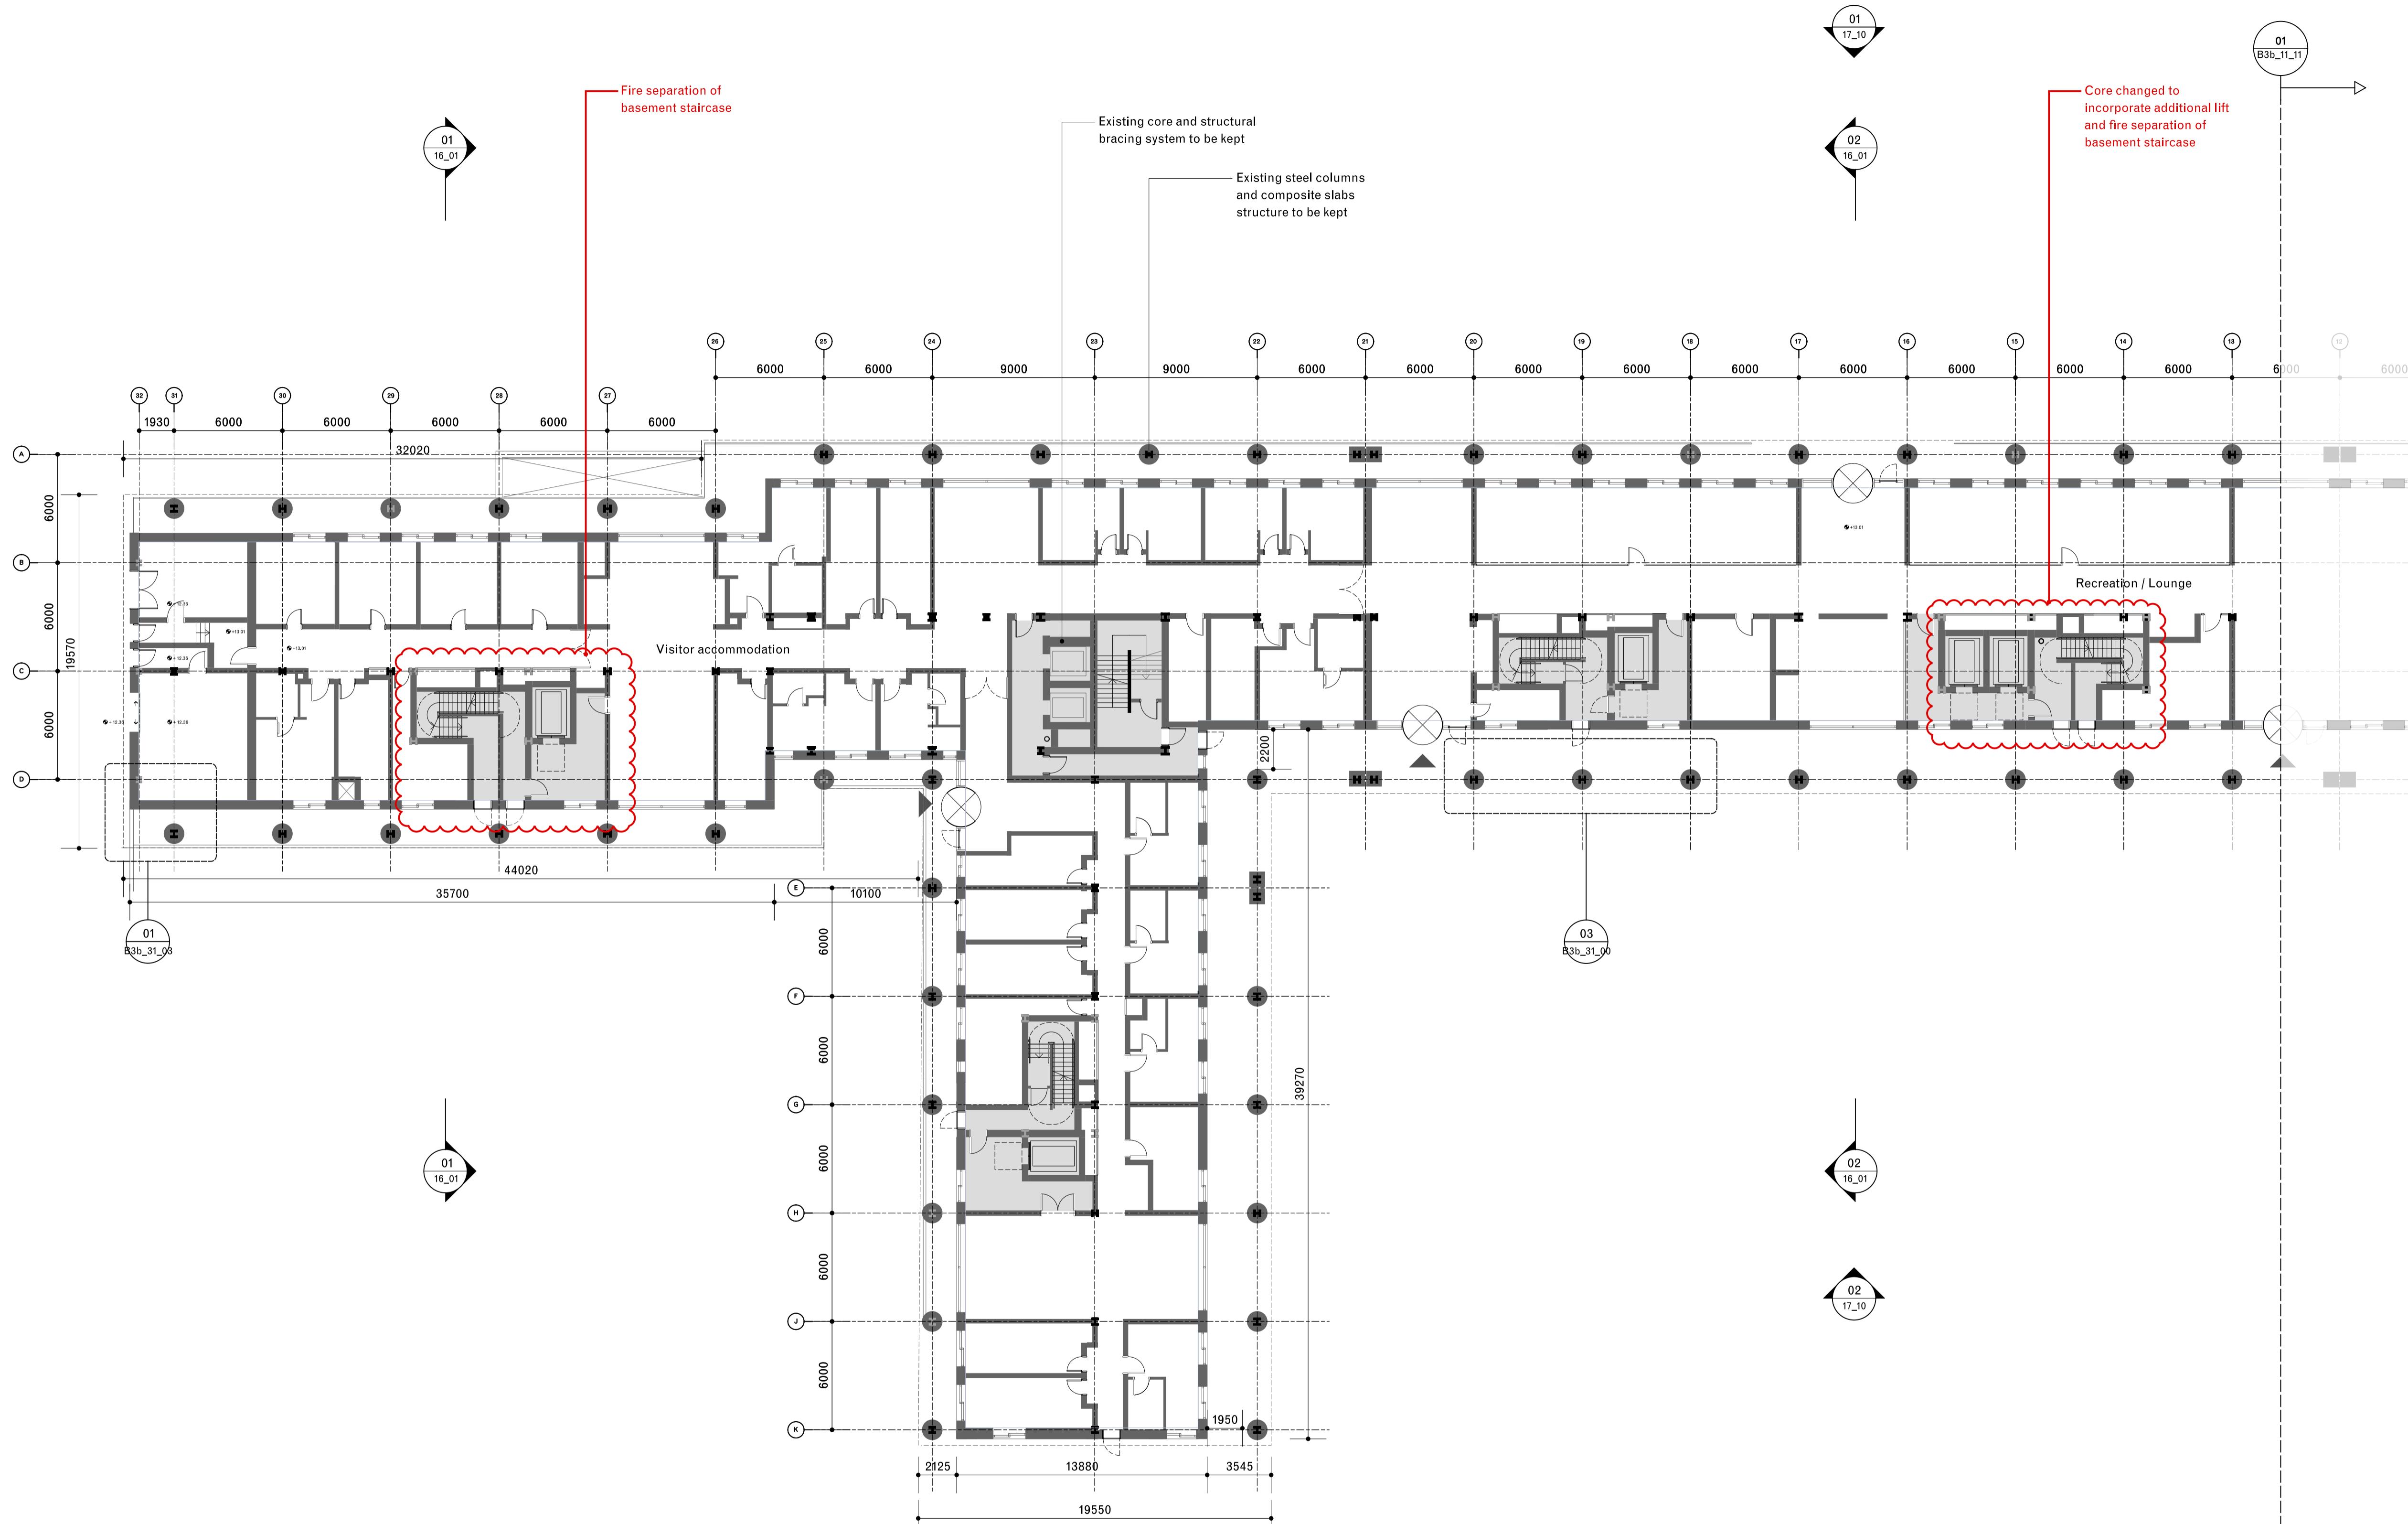

Note:
Red line shows amendments made to the original 2021 application to ensure compliance with updated legislation, including the Building Safety Act 2022 and BS9991:2024, as presented at the Planning Inquiry.

General notes:
Do not scale from drawings.
Errors to be reported immediately to the Architect.
To be read in conjunction with all relevant Architects', Services and Structural Engineers' drawings.
All existing site, tree and building information has been compiled from different sources.
All dimensions to be checked on site.

02 20/08/2025 Planning (addendum 3) MY GLa
01 15/11/2024 Planning (addendum) YZ GLa
Rev. Date Description Drawn Check

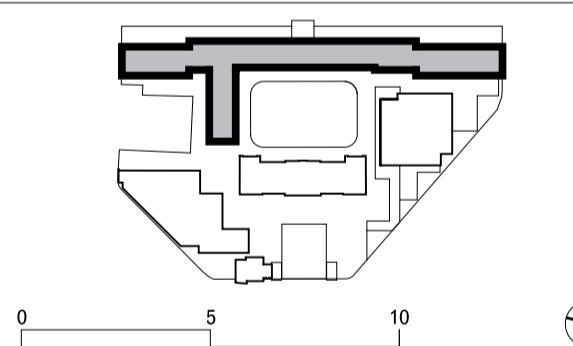

David Chipperfield Architects

C/O Fora, 9 Dillington Street
London EC1V 8LW
T +44 20 7829 4800
www.davidchipperfield.com

Project Royal Mint Court
Project number 1510

Client Chinese Embassy in the UK

Planning (addendum)

Drawing name Proposed ground floor plan Embassy House North, sheet 1 of 2
Drawing number B3b_11_10
Date 16/05/2024
Scale / Format 1:200 / A1
Drawn / Checked BB
Approved
CAD Reference 1510_A_B3b_1_10.dgn
Revision 02
Planning




Note:
Red line shows amendments made to the original 2021 application to ensure compliance with updated legislation, including the Building Safety Act 2022 and BS9991:2024, as presented at the Planning Inquiry.

General notes:

- Do not scale from drawings.
- Errors to be reported immediately to the Architect.
- To be read in conjunction with all relevant Architects', Services and Structural Engineers' drawings.
- All existing site, tree and building information has been compiled from different sources.
- All dimensions to be checked on site.

The legend consists of four entries: 'Existing' with a black square, 'Proposed' with a grey square, 'Retained column' with a black square containing a white 'H', and 'New column' with a grey square containing a white 'H'.

02	20/08/2025	Planning (addendum 3)	MY	GLa
01	15/11/2024	Planning (addendum)	YZ	GLa

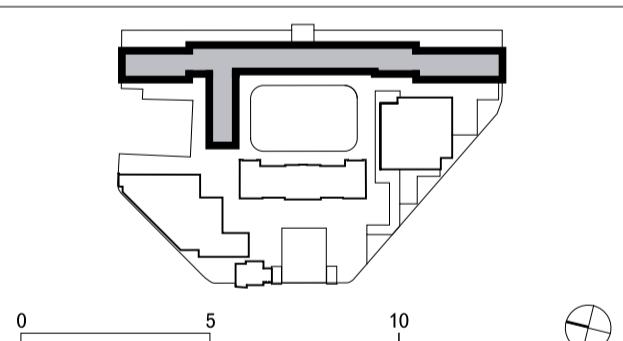

David Chipperfield Architects

C/O Fora, 9 Dallington Street
London EC1V 0LN
T +44 20 7620 4800
www.davidchipperfield.com

Project P **Royal Mint Court**

Client

Planning (addendum)

Drawing name Drawing number

Proposed ground floor plan **B3b_11_**

Embassy House

Date	16/05/2024	Revision
Scale / Format	1:200 / A1	02
Drawn / Checked	THN / GLa	Planning
Approved	BB	
CAD Reference	1510_A_B3b_11_11.dgn	

