

01 Proposed First Floor Plan, South Scale 1:200

© David Chipperfield Architects Ltd.

Chinese Embassy in the UK

Project number:

Chinese Embassy in the UK

© David Chipperfield Architects

Worfield Architects Ltd.

Planning (addendum)

m)

name Drawing no.
sed first floor plan
y House B3b_1

Drawing number

sheet 2 of 2

16/05/2024
1:200 / A1
THN / OU, GLa
BB


16/05/2024
1:200 / A1
THN / OU, GLa
BB

Revision 22

Checked **THN / OU, GLa** **BB** **Pla**
d

02 Planning

ference 1510_A_B3b_11_13.dgn

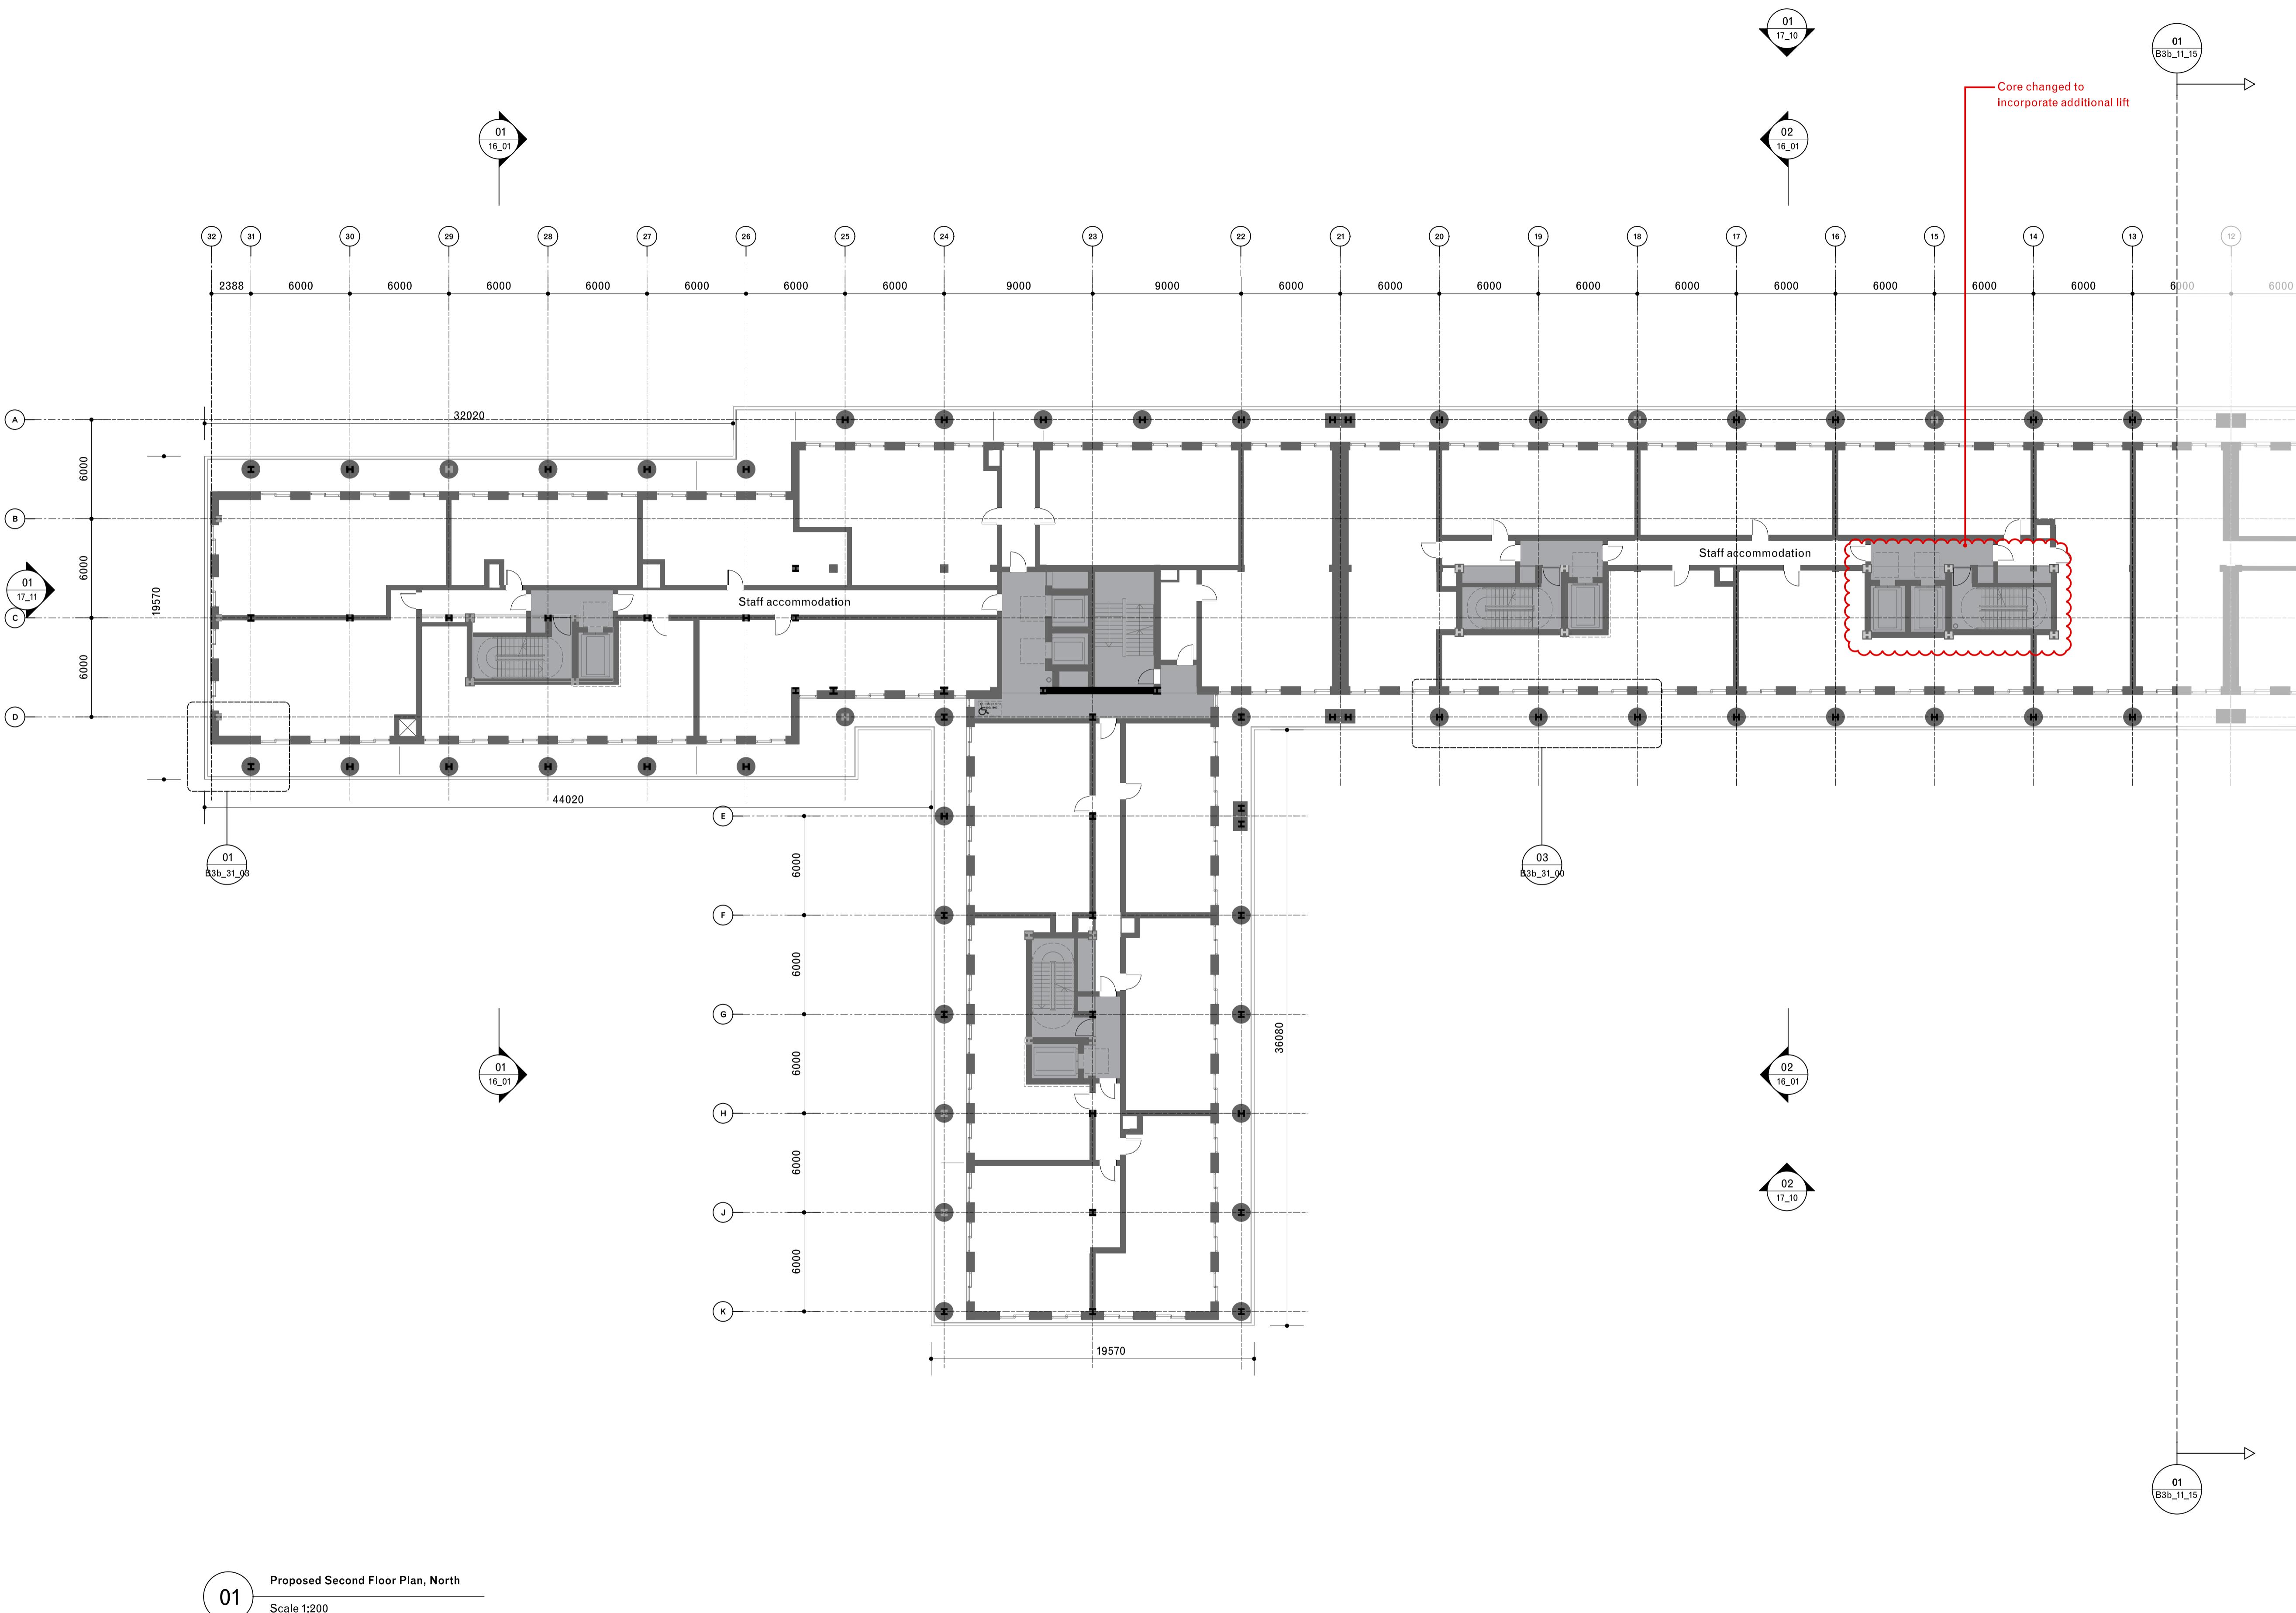


Note:
Red line shows amendments made to the original 2021 application to ensure compliance with updated legislation, including the Building Safety Act 2022 and BS9991:2024, as presented at the Planning Inquiry.

General notes:
Do not scale from drawings.
Errors to be reported immediately to the Architect.
To be read in conjunction with all relevant Architects', Services and Structural Engineers' drawings.
All existing site, tree and building information has been compiled from different sources.
All dimensions to be checked on site.

■ Existing
■ Proposed
■ Retained column
■ New column

02 20/08/2025 Planning (addendum 3) MY GLa
01 15/11/2024 Planning (addendum) YZ GLa
Rev. Date Description Drawn Check

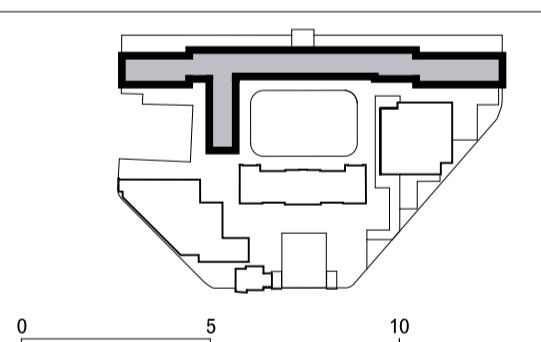

David Chipperfield Architects

C/O Fora, 9 Dillington Street
London EC1V 8LW
T +44 20 7829 4800
www.davidchipperfield.com

Project Royal Mint Court
Project number 1510


Client Chinese Embassy in the UK

Planning (addendum)

Drawing name Proposed second floor plan
Drawing number B3b_11_14

Date 16/05/2024
Scale / Format 1:200 / A1
Drawn / Checked THN / OU, GLa
Approved BB
CAD Reference 1510_A_B3b_1_14.dgn

Revision 02
Planning

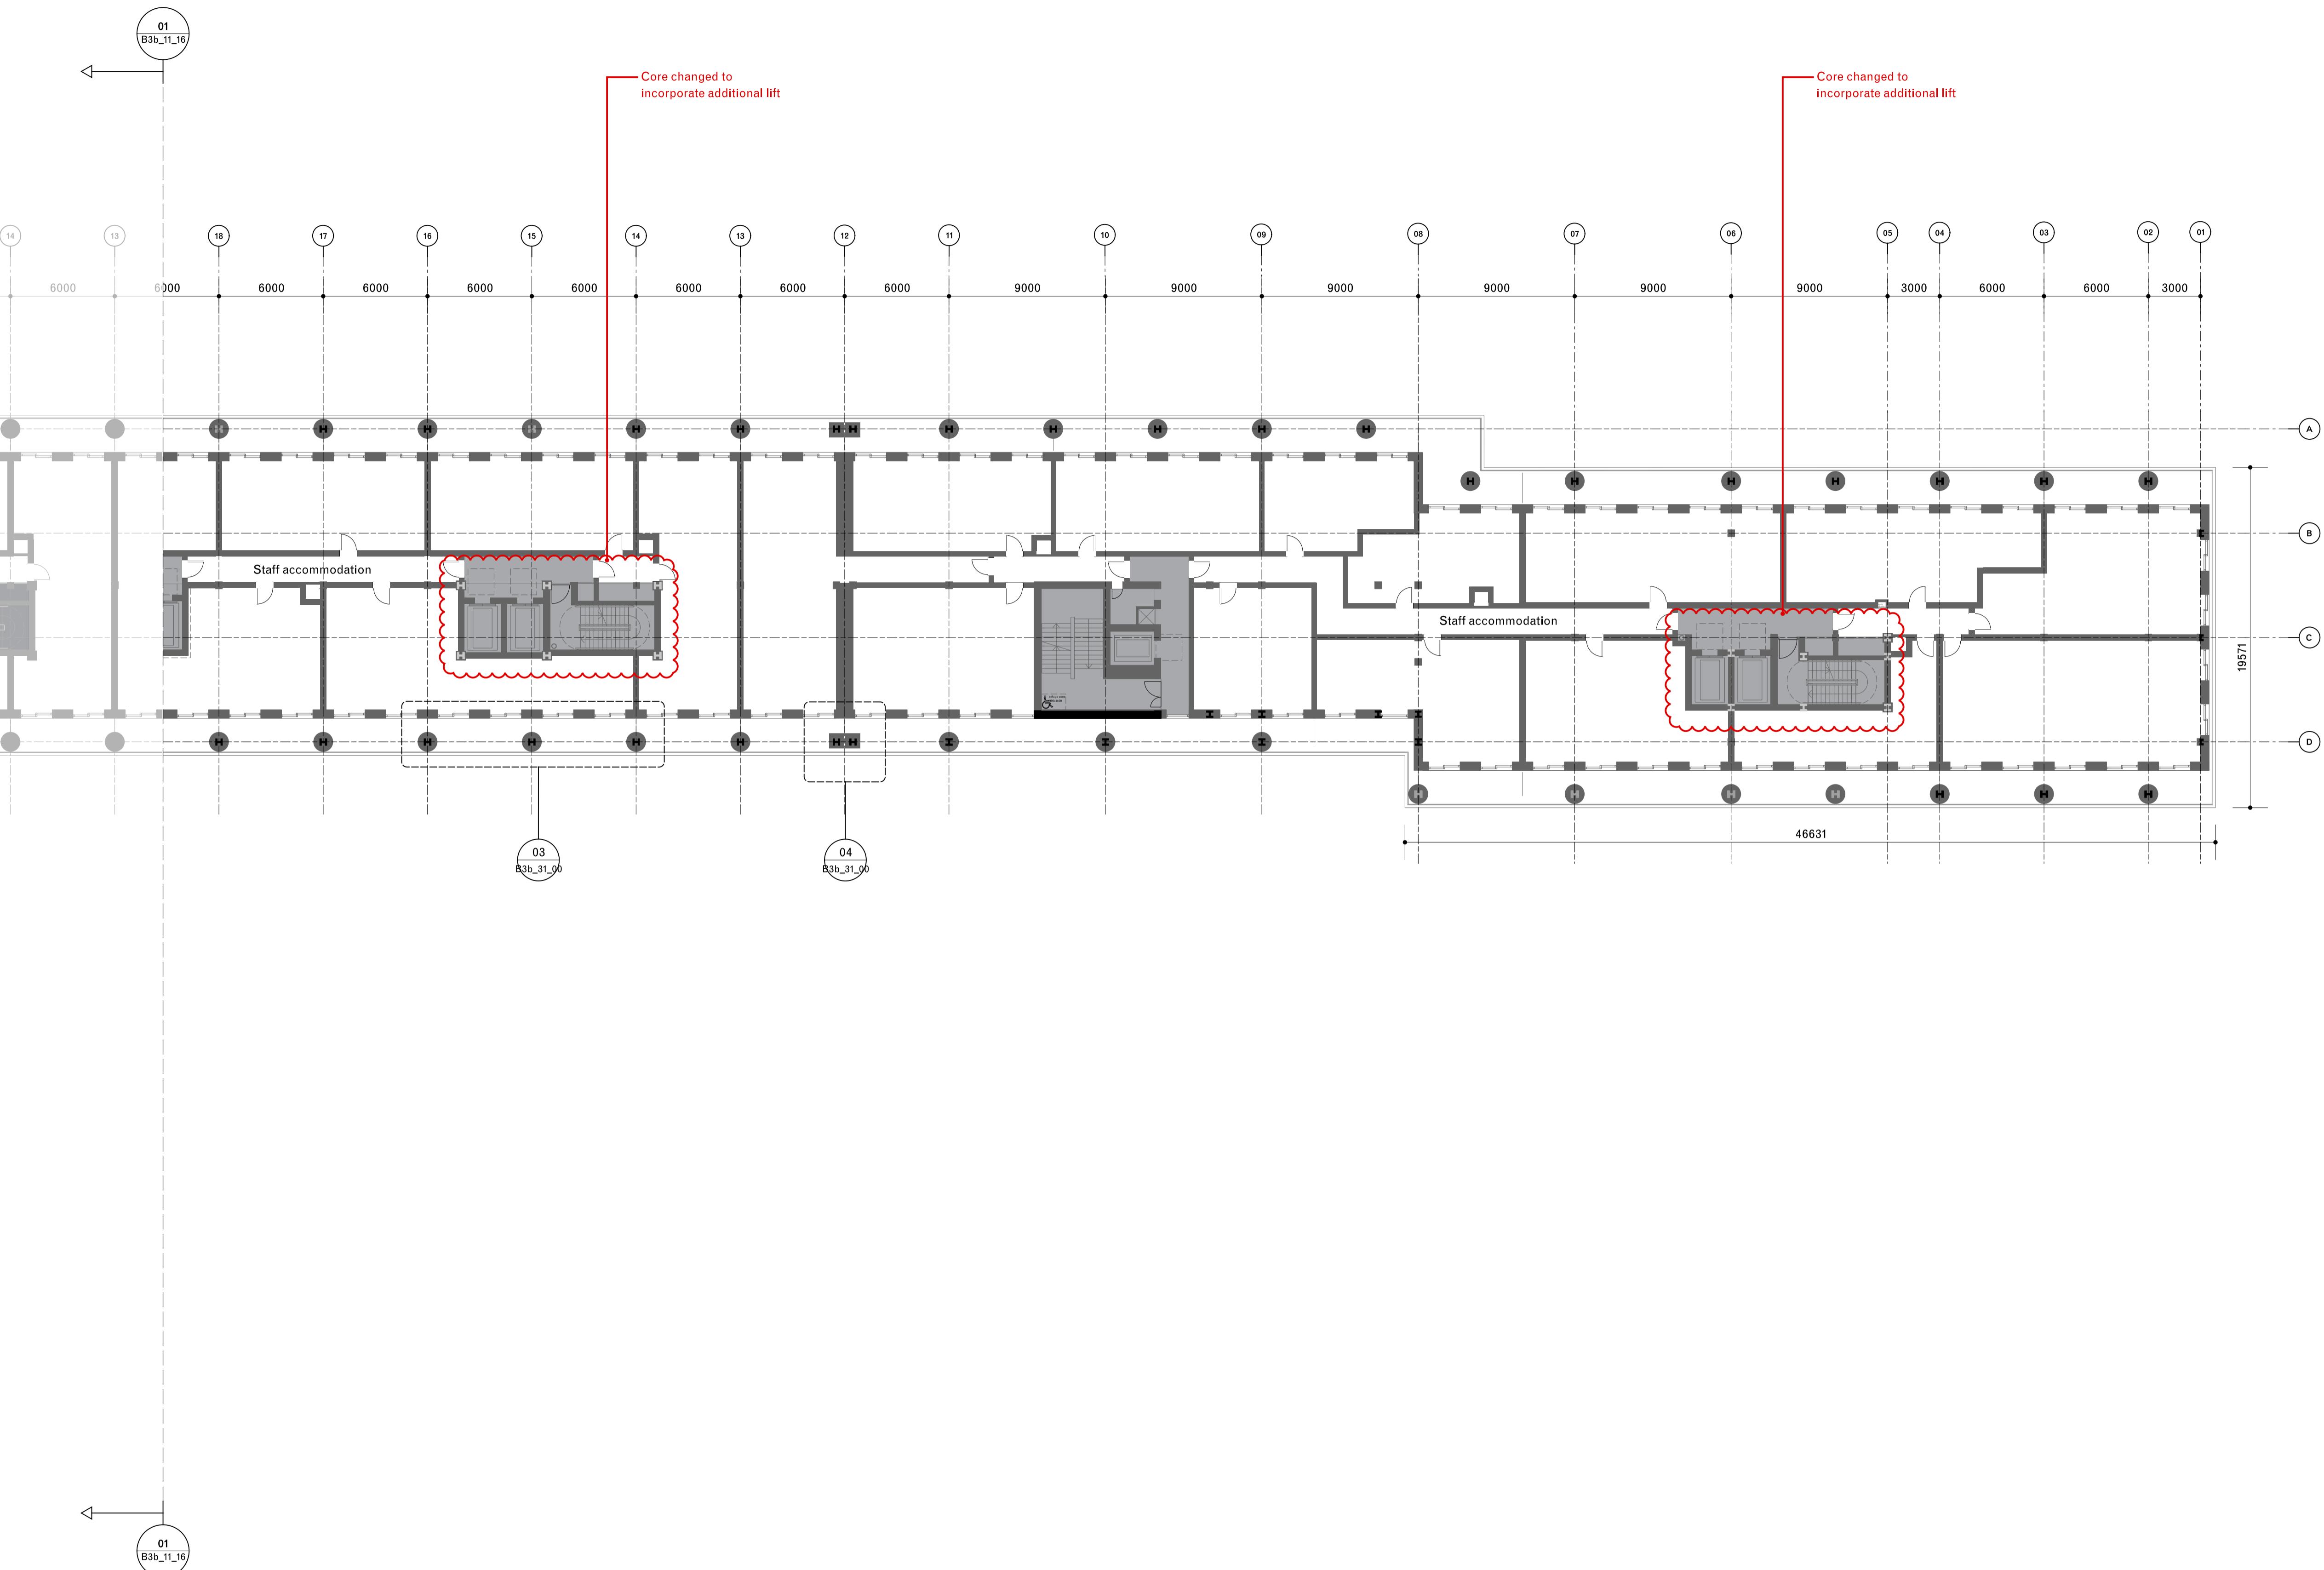


01
Proposed Second Floor Plan, South
Scale 1:200

Note:
Red line shows amendments made to the original 2021 application to ensure compliance with updated legislation, including the Building Safety Act 2022 and BS9991:2024, as presented at the Planning Inquiry.

General notes:
Do not scale from drawings.
Errors to be reported immediately to the Architect.
To be read in conjunction with all relevant Architects', Services and Structural Engineers' drawings.
All existing site, tree and building information has been compiled from different sources.
All dimensions to be checked on site.

Existing
Proposed
Retained column
New column

02 20/08/2025 Planning (addendum 3) MY GLa
01 15/11/2024 Planning (addendum) YZ GLa
Rev. Date Description Drawn Check

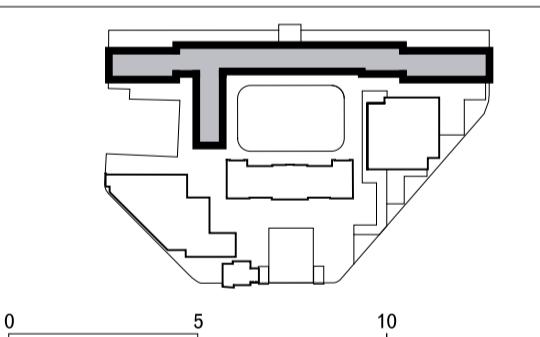

David Chipperfield Architects

C/O Fora, 9 Dillington Street
London EC1V 8LW
T +44 20 7829 4800
www.davidchipperfield.com

Project Royal Mint Court
Project number 1510

Client Chinese Embassy in the UK

© David Chipperfield Architects Ltd.

Planning (addendum)

Drawing name Drawing number


Proposed second floor plan
Embassy House
South, sheet 2 of 2

B3b_11_15

Date 16/05/2024
Scale / Format 1:200 / A1
Drawn / Checked THN / OU, GLa
Approved BB
CAD Reference 1510_A_B3b_1_15.dgn

Revision 02
Planning

01 Proposed Third Floor Plan, North
Scale 1:200

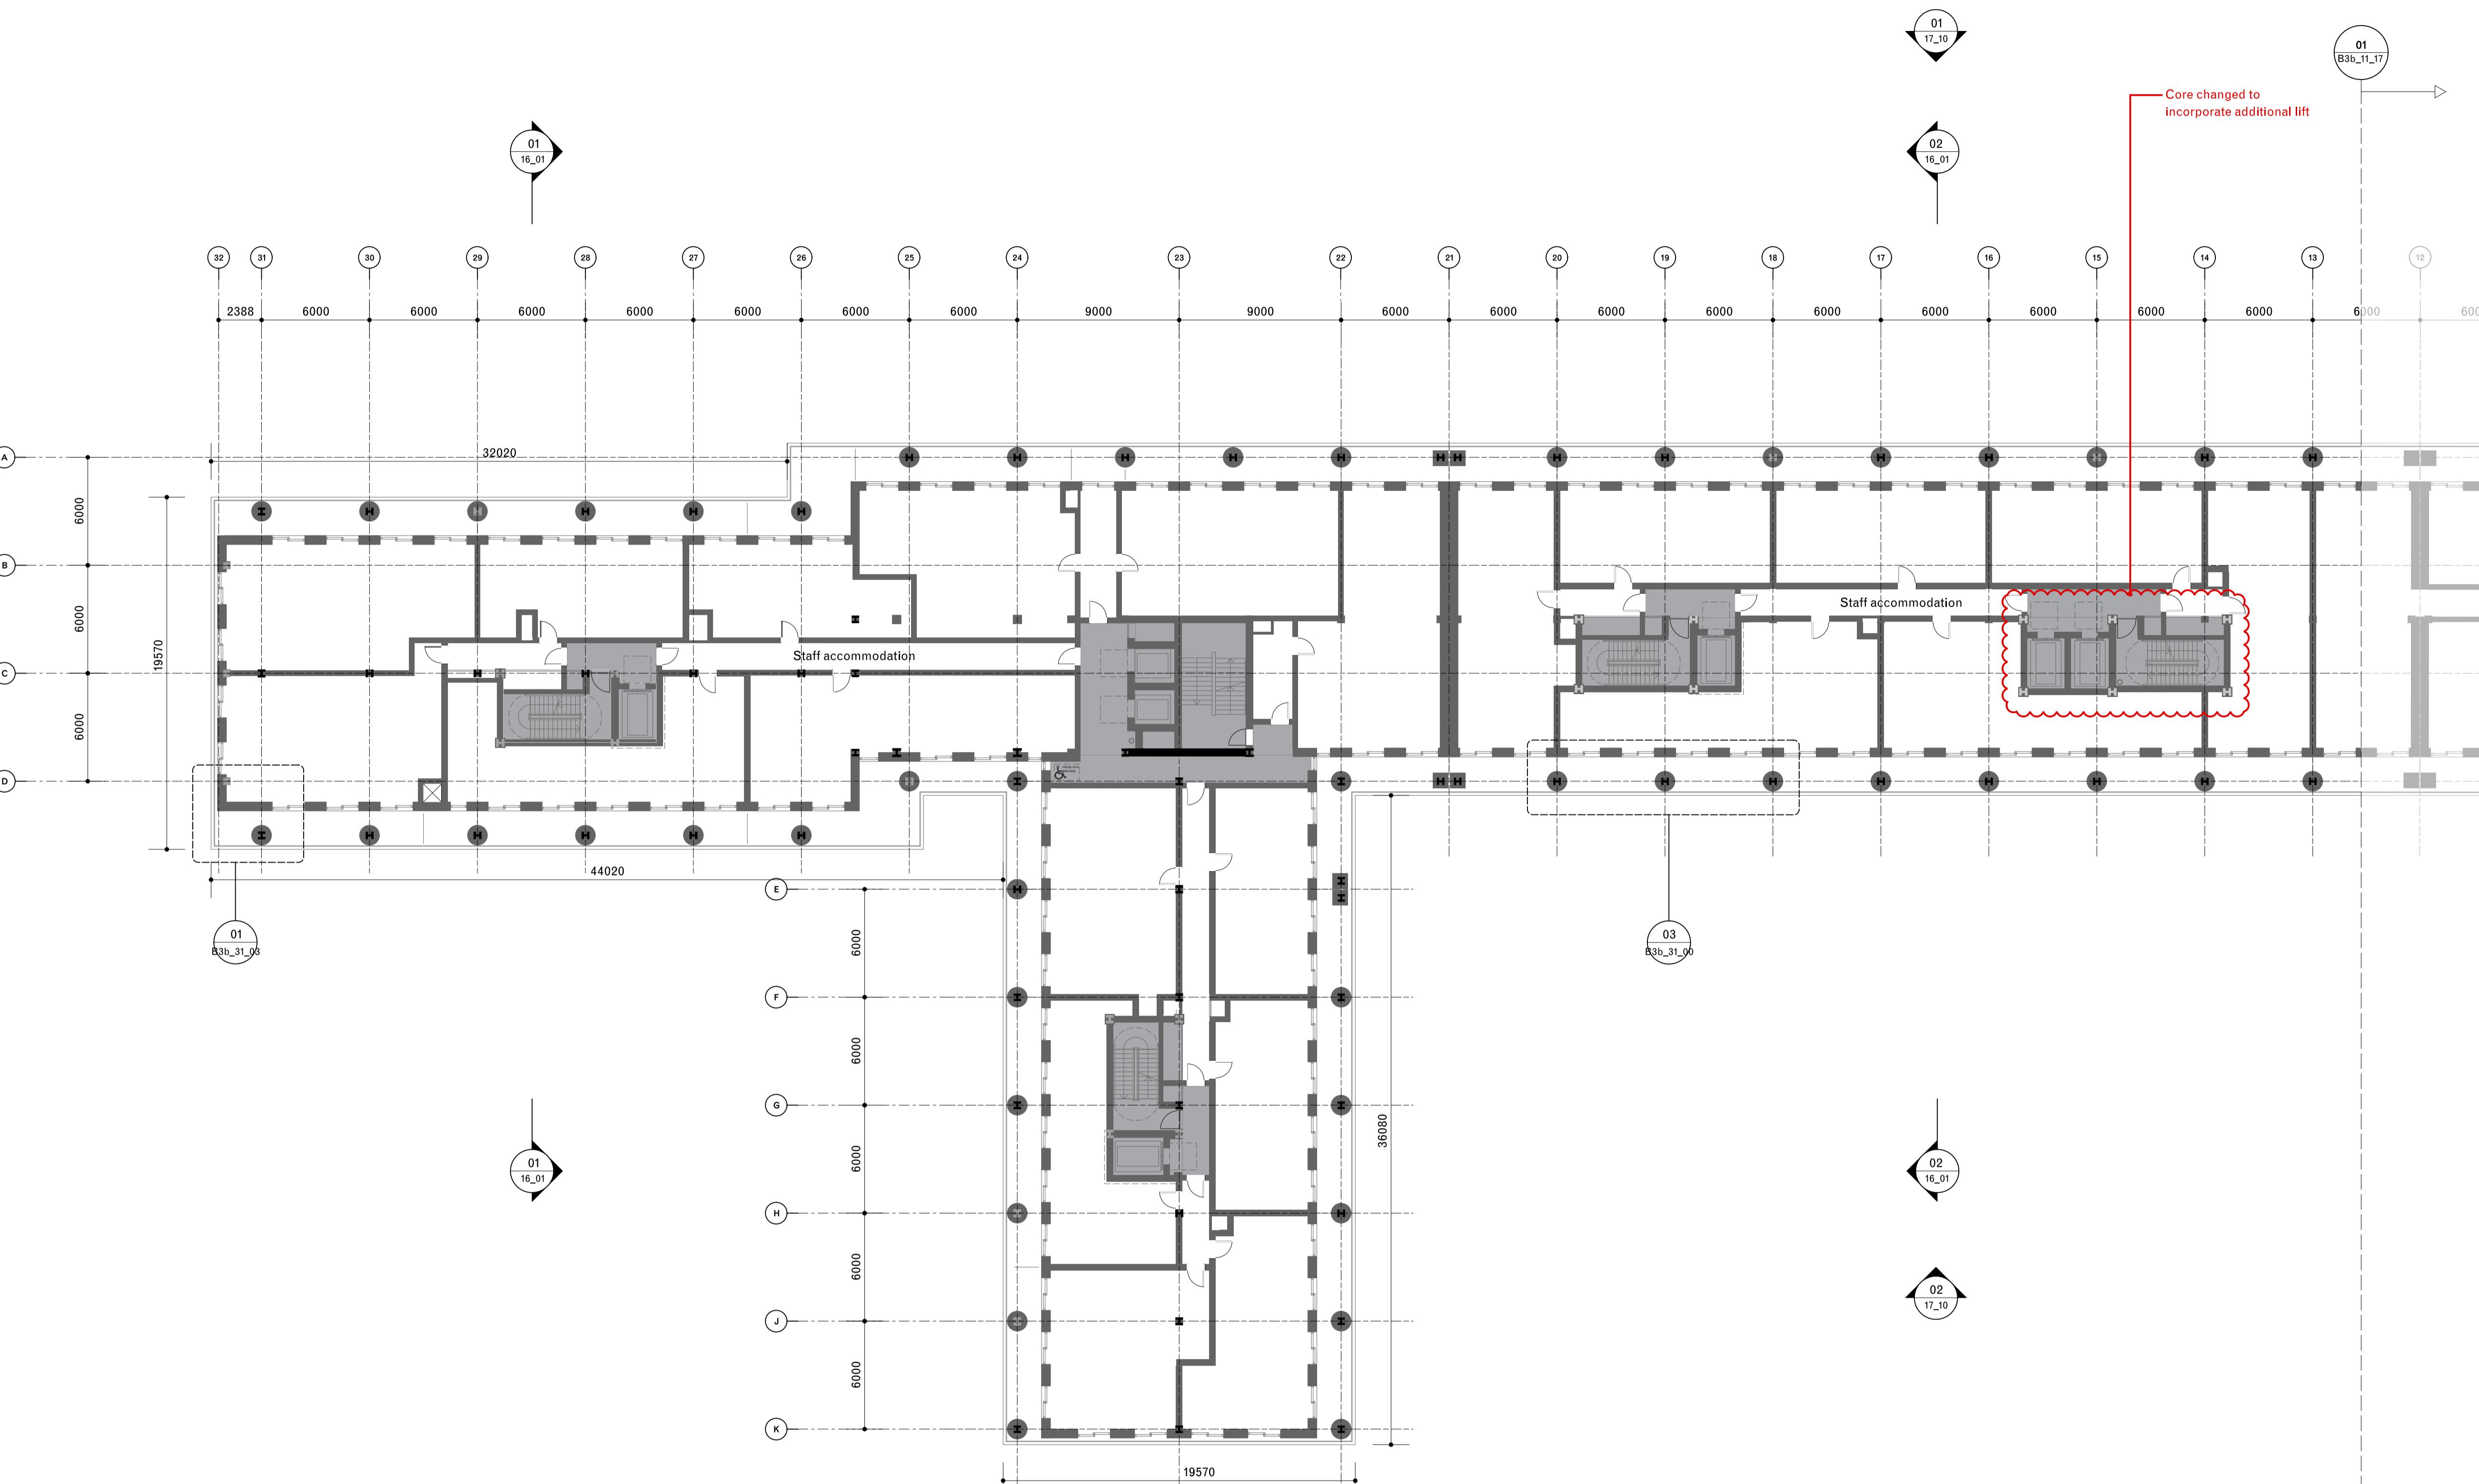


Note:
Red line shows amendments made to the original 2021 application to ensure compliance with updated legislation, including the Building Safety Act 2022 and BS9991:2024, as presented at the Planning Inquiry.

General notes:
Do not scale from drawings.
Errors to be reported immediately to the Architect.
To be read in conjunction with all relevant Architects', Services and Structural Engineers' drawings.
All existing site, tree and building information has been compiled from different sources.
All dimensions to be checked on site.

■ Existing
■ Proposed
■ Retained column
■ New column

02 20/08/2025 Planning (addendum 3) MY GLA
01 15/11/2024 Planning (addendum) YZ GLA
Rev. Date Description Drawn Check

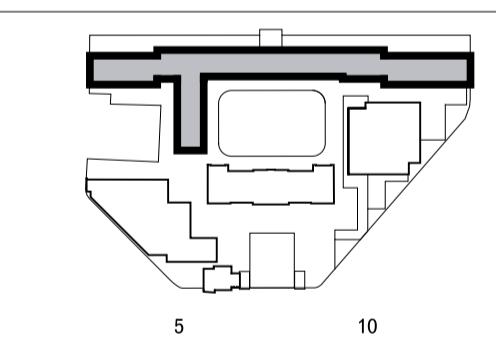

David Chipperfield Architects

C/O Fora, 9 Dillington Street
London EC1V 8LW
T +44 20 7829 4800
www.davidchipperfield.com

Project Royal Mint Court
Project number 1510

Client Chinese Embassy in the UK

© David Chipperfield Architects Ltd.

Planning (addendum)

Drawing name Drawing number

Proposed third floor plan
Embassy House
North, sheet 1 of 2

Date 16/05/2024

Scale / Format 1:200 / A1


Drawn / Checked THN / OU, GLA

Approved BB

CAD Reference 1510_A_B3b_1_16.dgn

Revision 02

Planning

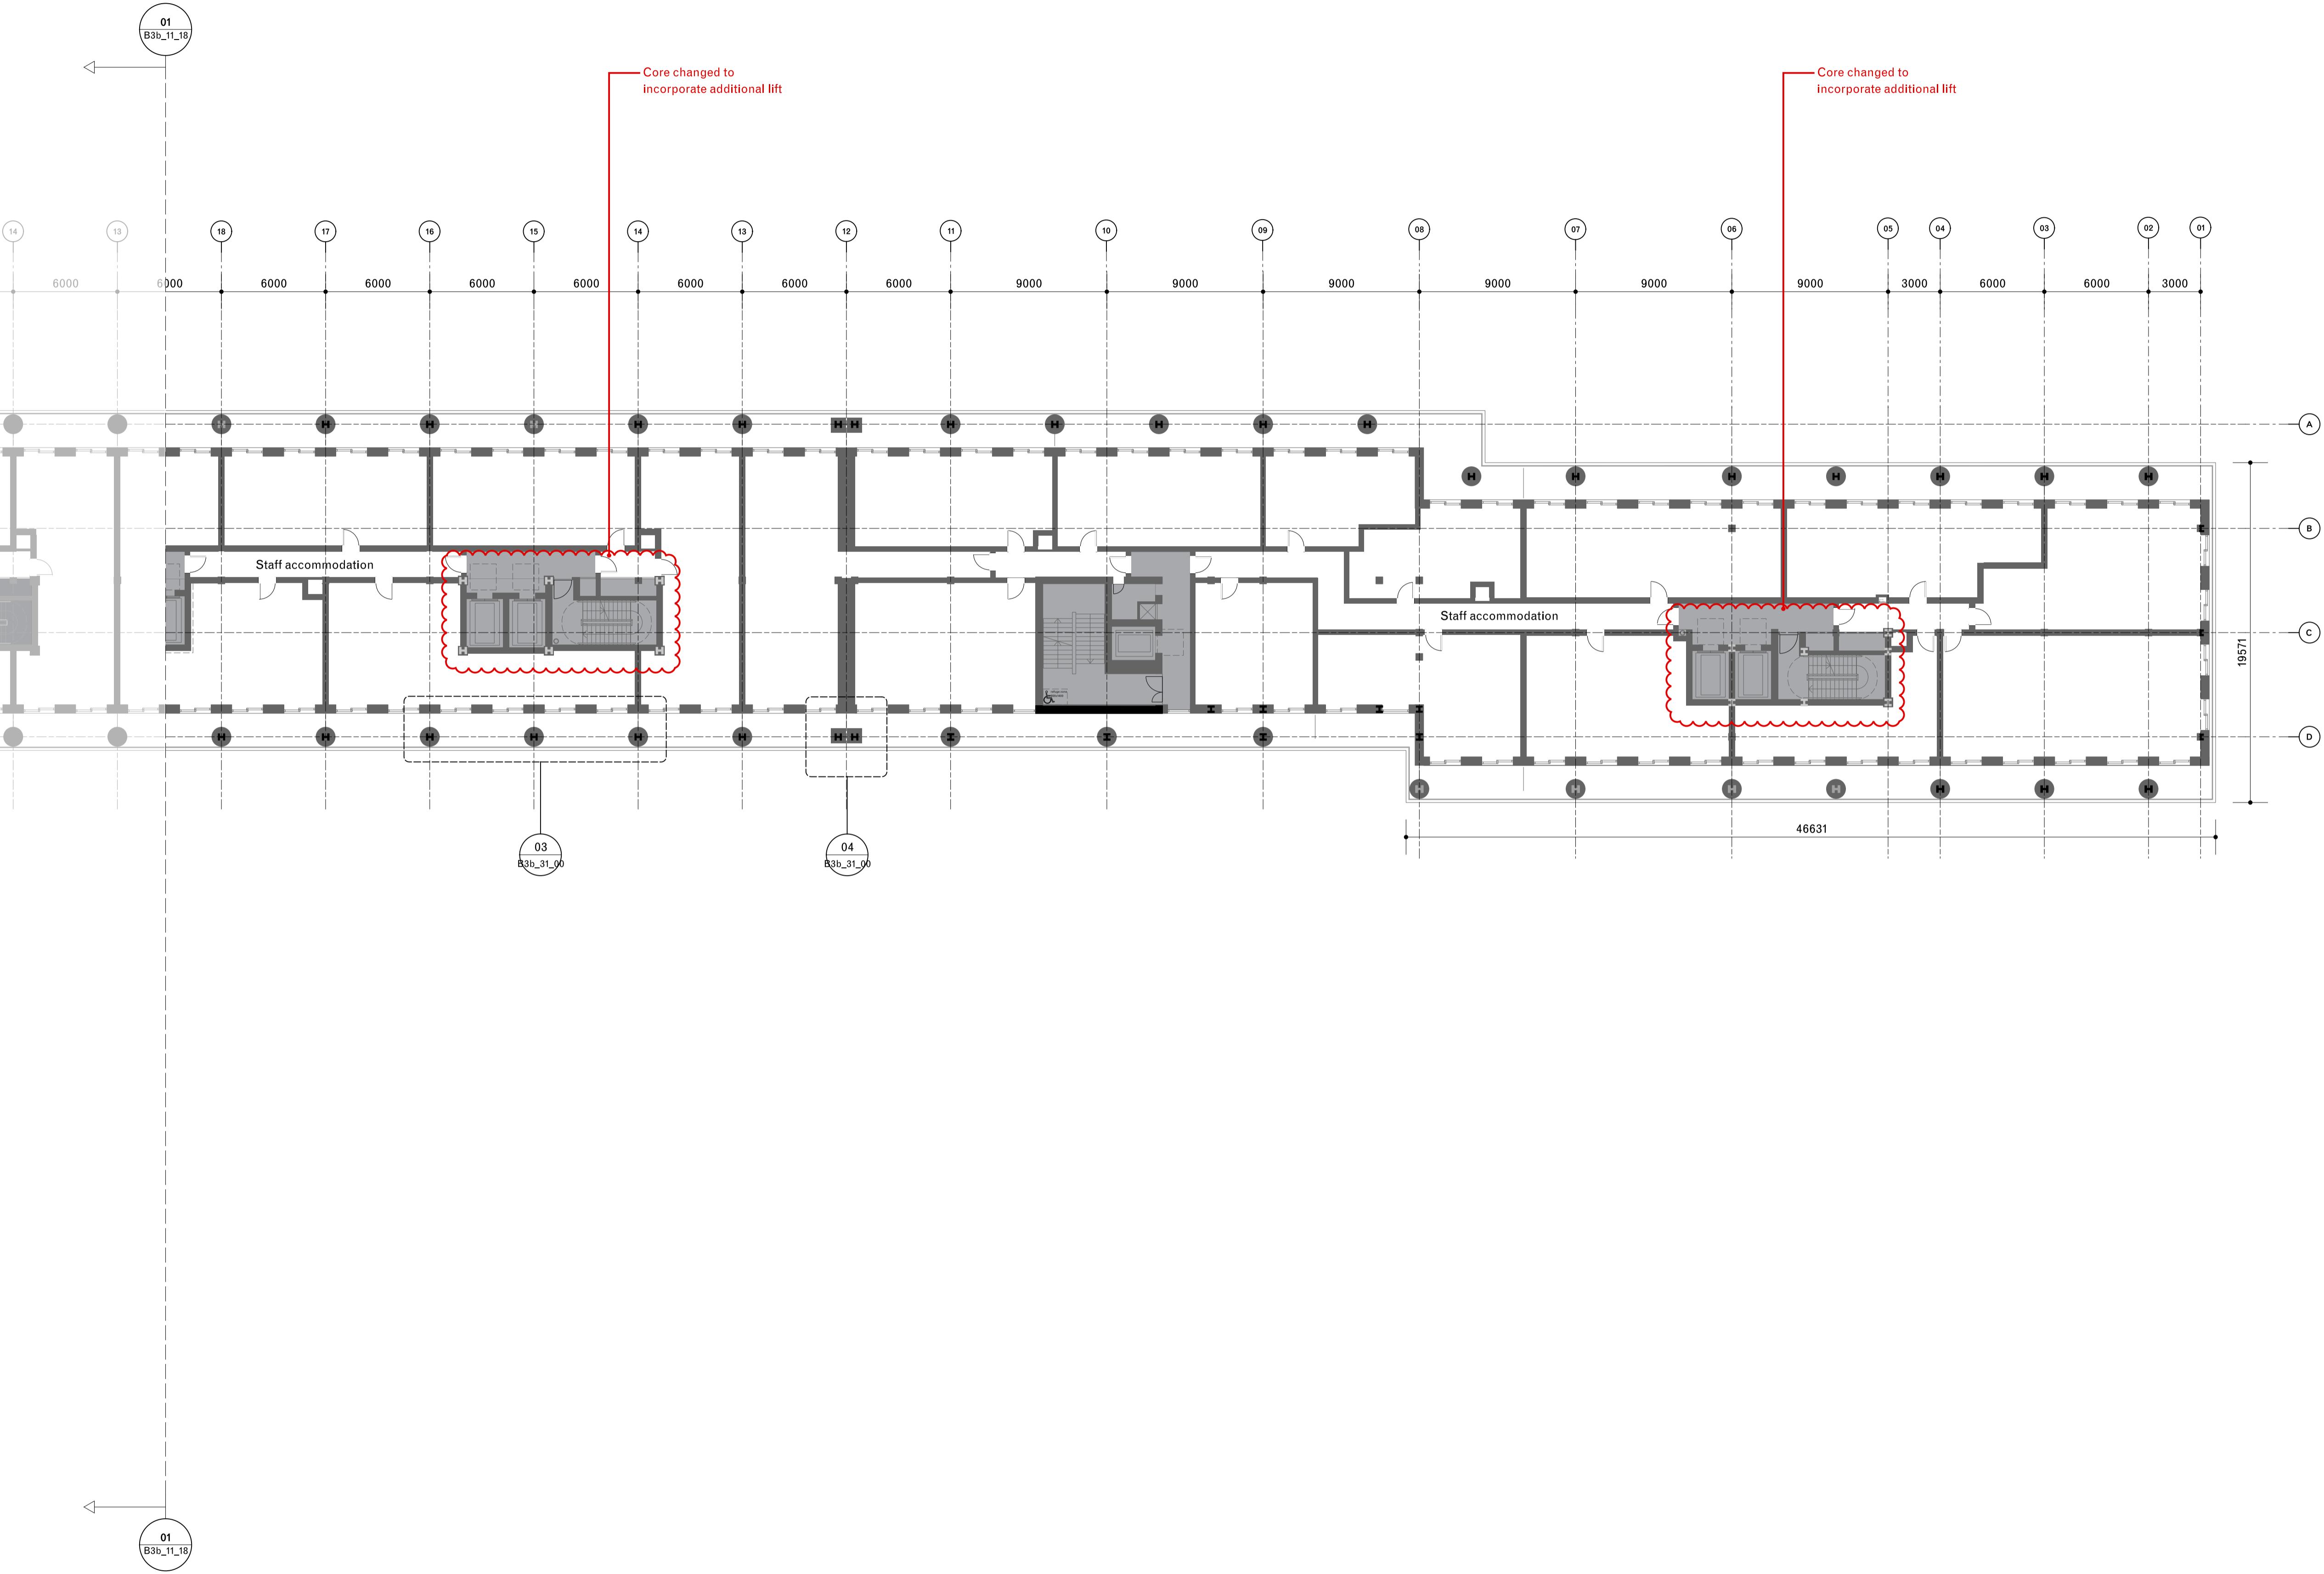


01
Proposed Third Floor Plan, South
Scale 1:200

Note:
Red line shows amendments made to the original 2021 application to ensure compliance with updated legislation, including the Building Safety Act 2022 and BS9991:2024, as presented at the Planning Inquiry.

General notes:
Do not scale from drawings.
Errors to be reported immediately to the Architect.
To be read in conjunction with all relevant Architects', Services and Structural Engineers' drawings.
All existing site, tree and building information has been compiled from different sources.
All dimensions to be checked on site.

02
17_11

02 20/08/2025 Planning (addendum 3) MY GLa
01 15/11/2024 Planning (addendum) YZ GLa
Rev. Date Description Drawn Check

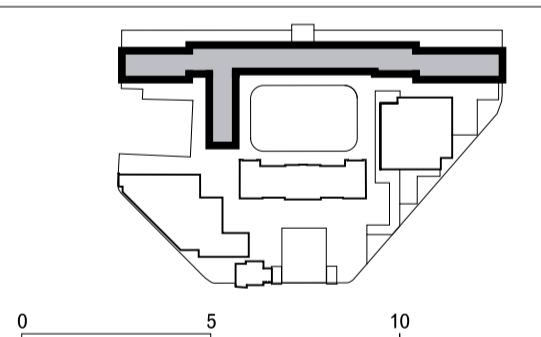

David Chipperfield Architects

C/O Fora, 9 Dillington Street
London EC1V 8LW
T +44 20 7829 4800
www.davidchipperfield.com

Project Royal Mint Court
Project number 1510

Client Chinese Embassy in the UK

© David Chipperfield Architects Ltd.

Planning (addendum)

Drawing name Drawing number

Proposed third floor plan
Embassy House
South, sheet 2 of 2

Date 16/05/2024
Scale / Format 1:200 / A1
Drawn / Checked THN / OU, GLa
Approved BB
CAD Reference 1510_A_B3b_11_17.dgn

Revision 02
Planning

Date 16/05/2024
Scale / Format 1:200 / A1
Drawn / Checked THN / OU, GLa
Approved BB
CAD Reference 1510_A_B3b_11_17.dgn

Revision 02
Planning

Date 16/05/2024
Scale / Format 1:200 / A1
Drawn / Checked THN / OU, GLa
Approved BB
CAD Reference 1510_A_B3b_11_17.dgn

Revision 02
Planning

Date 16/05/2024
Scale / Format 1:200 / A1
Drawn / Checked THN / OU, GLa
Approved BB
CAD Reference 1510_A_B3b_11_17.dgn

Revision 02
Planning

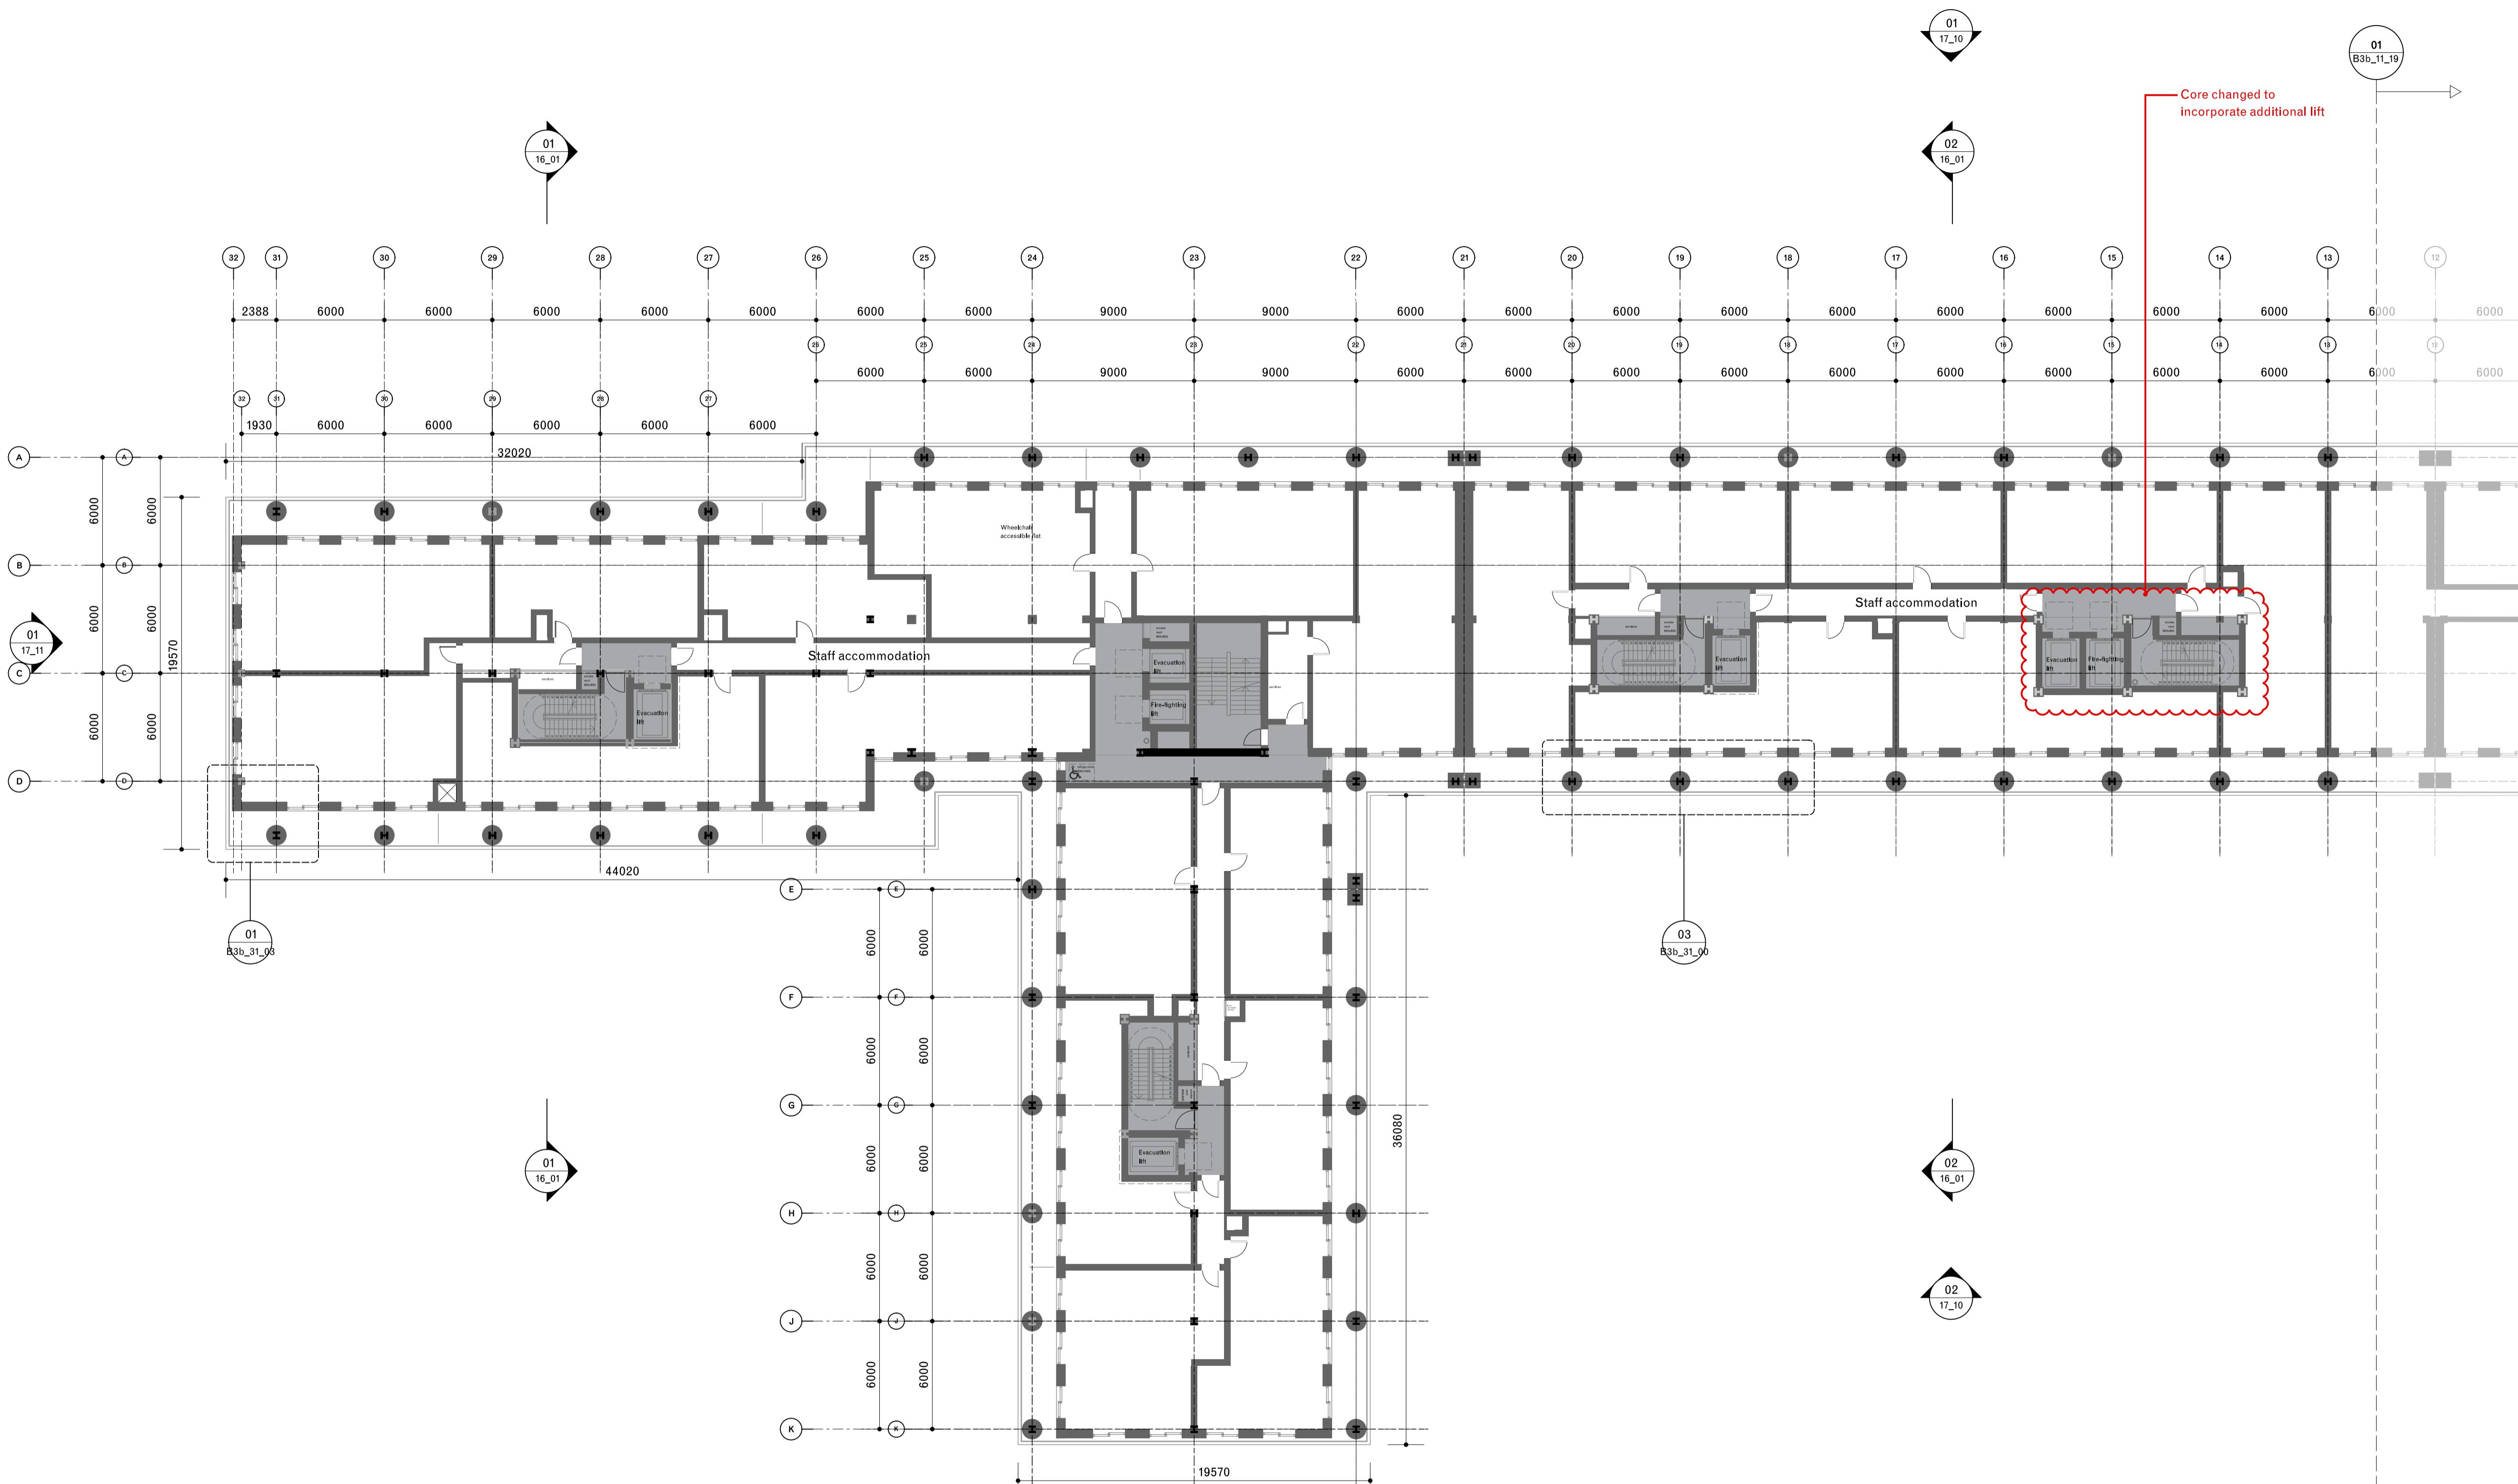


01
Proposed Fourth Floor Plan, North
Scale 1:200

Note:
Red line shows amendments made to the original 2021 application to ensure compliance with updated legislation, including the Building Safety Act 2022 and BS9991:2024, as presented at the Planning Inquiry.

General notes:
Do not scale from drawings.
Errors to be reported immediately to the Architect.
To be read in conjunction with all relevant Architects', Services and Structural Engineers' drawings.
All existing site, tree and building information has been compiled from different sources.
All dimensions to be checked on site.

02 20/08/2025 Planning (addendum 3) MY GLa
01 15/11/2024 Planning (addendum) YZ GLa
Rev. Date Description Drawn Check

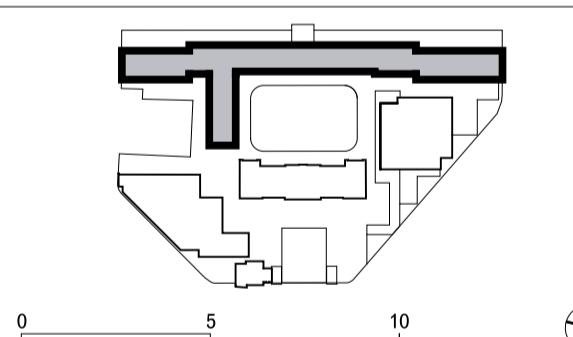

David Chipperfield Architects

C/O Fora, 9 Dillington Street
London EC1V 8LW
T +44 20 7829 4800
www.davidchipperfield.com

Project Royal Mint Court
Project number 1510

Client Chinese Embassy in the UK

© David Chipperfield Architects Ltd.


Planning (addendum)

Drawing name Drawing number

Proposed fourth floor plan
Embassy House
North, sheet 1 of 2

Date 16/05/2024
Scale / Format 1:200 / A1
Drawn / Checked BB
Approved
CAD Reference 1510_A_B3b_1_18.dgn

Revision 02
Planning

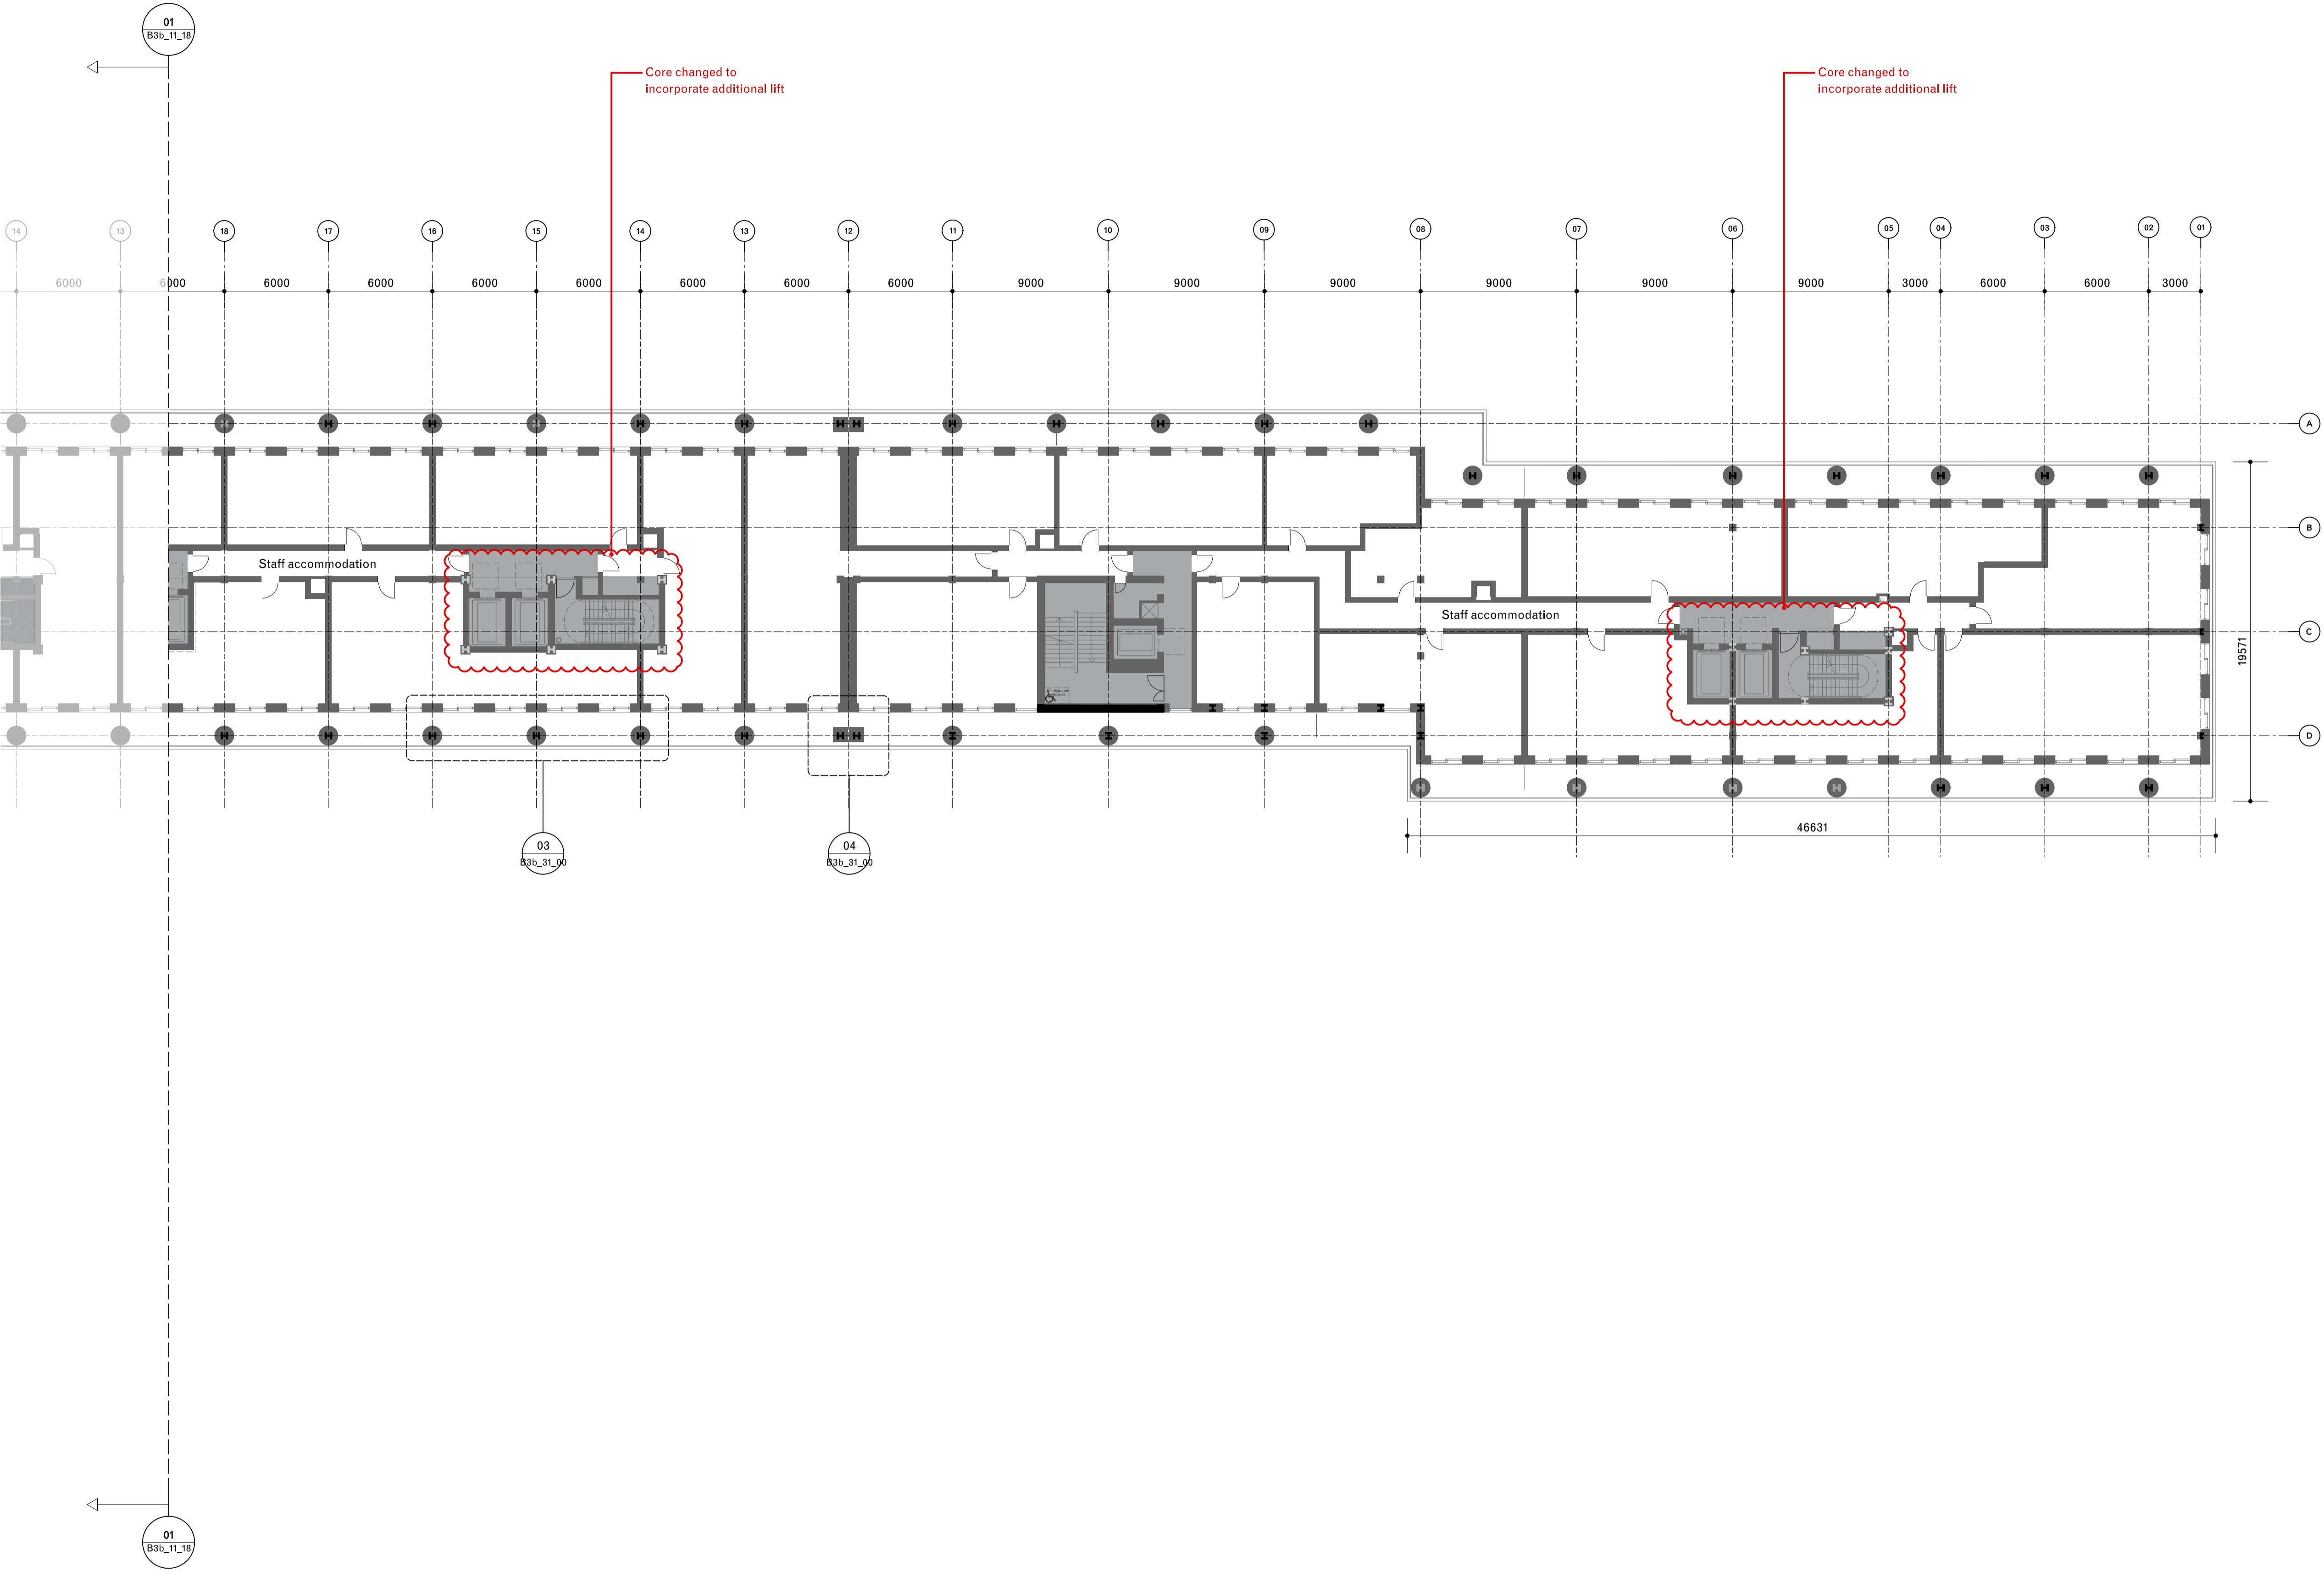


01
Proposed Fourth Floor Plan, South
Scale 1:200

Note:
Red line shows amendments made to the original 2021
application to ensure compliance with updated legislation,
including the Building Safety Act 2022 and BS9991:2024, as
presented at the Planning Inquiry.

General notes:
Do not scale from drawings.
Errors to be reported immediately to the Architect.
To be read in conjunction with all relevant Architects',
Services and Structural Engineers' drawings.
All existing site, tree and building information has been compiled
from different sources.
All dimensions to be checked on site.

02 20/08/2025 Planning (addendum 3) MY GLa
01 15/11/2024 Planning (addendum) YZ GLa
Rev. Date Description Drawn Check

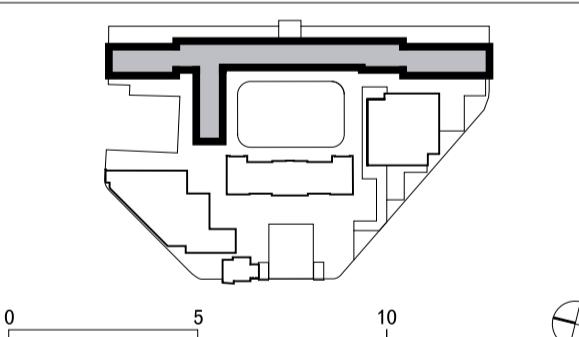

David Chipperfield Architects

C/O Fora, 9 Dillington Street
London EC1V 8LW
T +44 20 7829 4800
www.davidchipperfield.com

Project Royal Mint Court
Project number 1510

Client Chinese Embassy in the UK

© David Chipperfield Architects Ltd.

Planning (addendum)


Drawing name Drawing number

Proposed fourth floor plan
Embassy House
South, sheet 2 of 2

B3b_11_19

Date 16/05/2024
Scale / Format 1:200 / A1
Drawn / Checked THN / OU, GLa
Approved BB
CAD Reference 1510_A_B3b_1_19.dgn

Revision 02
Planning

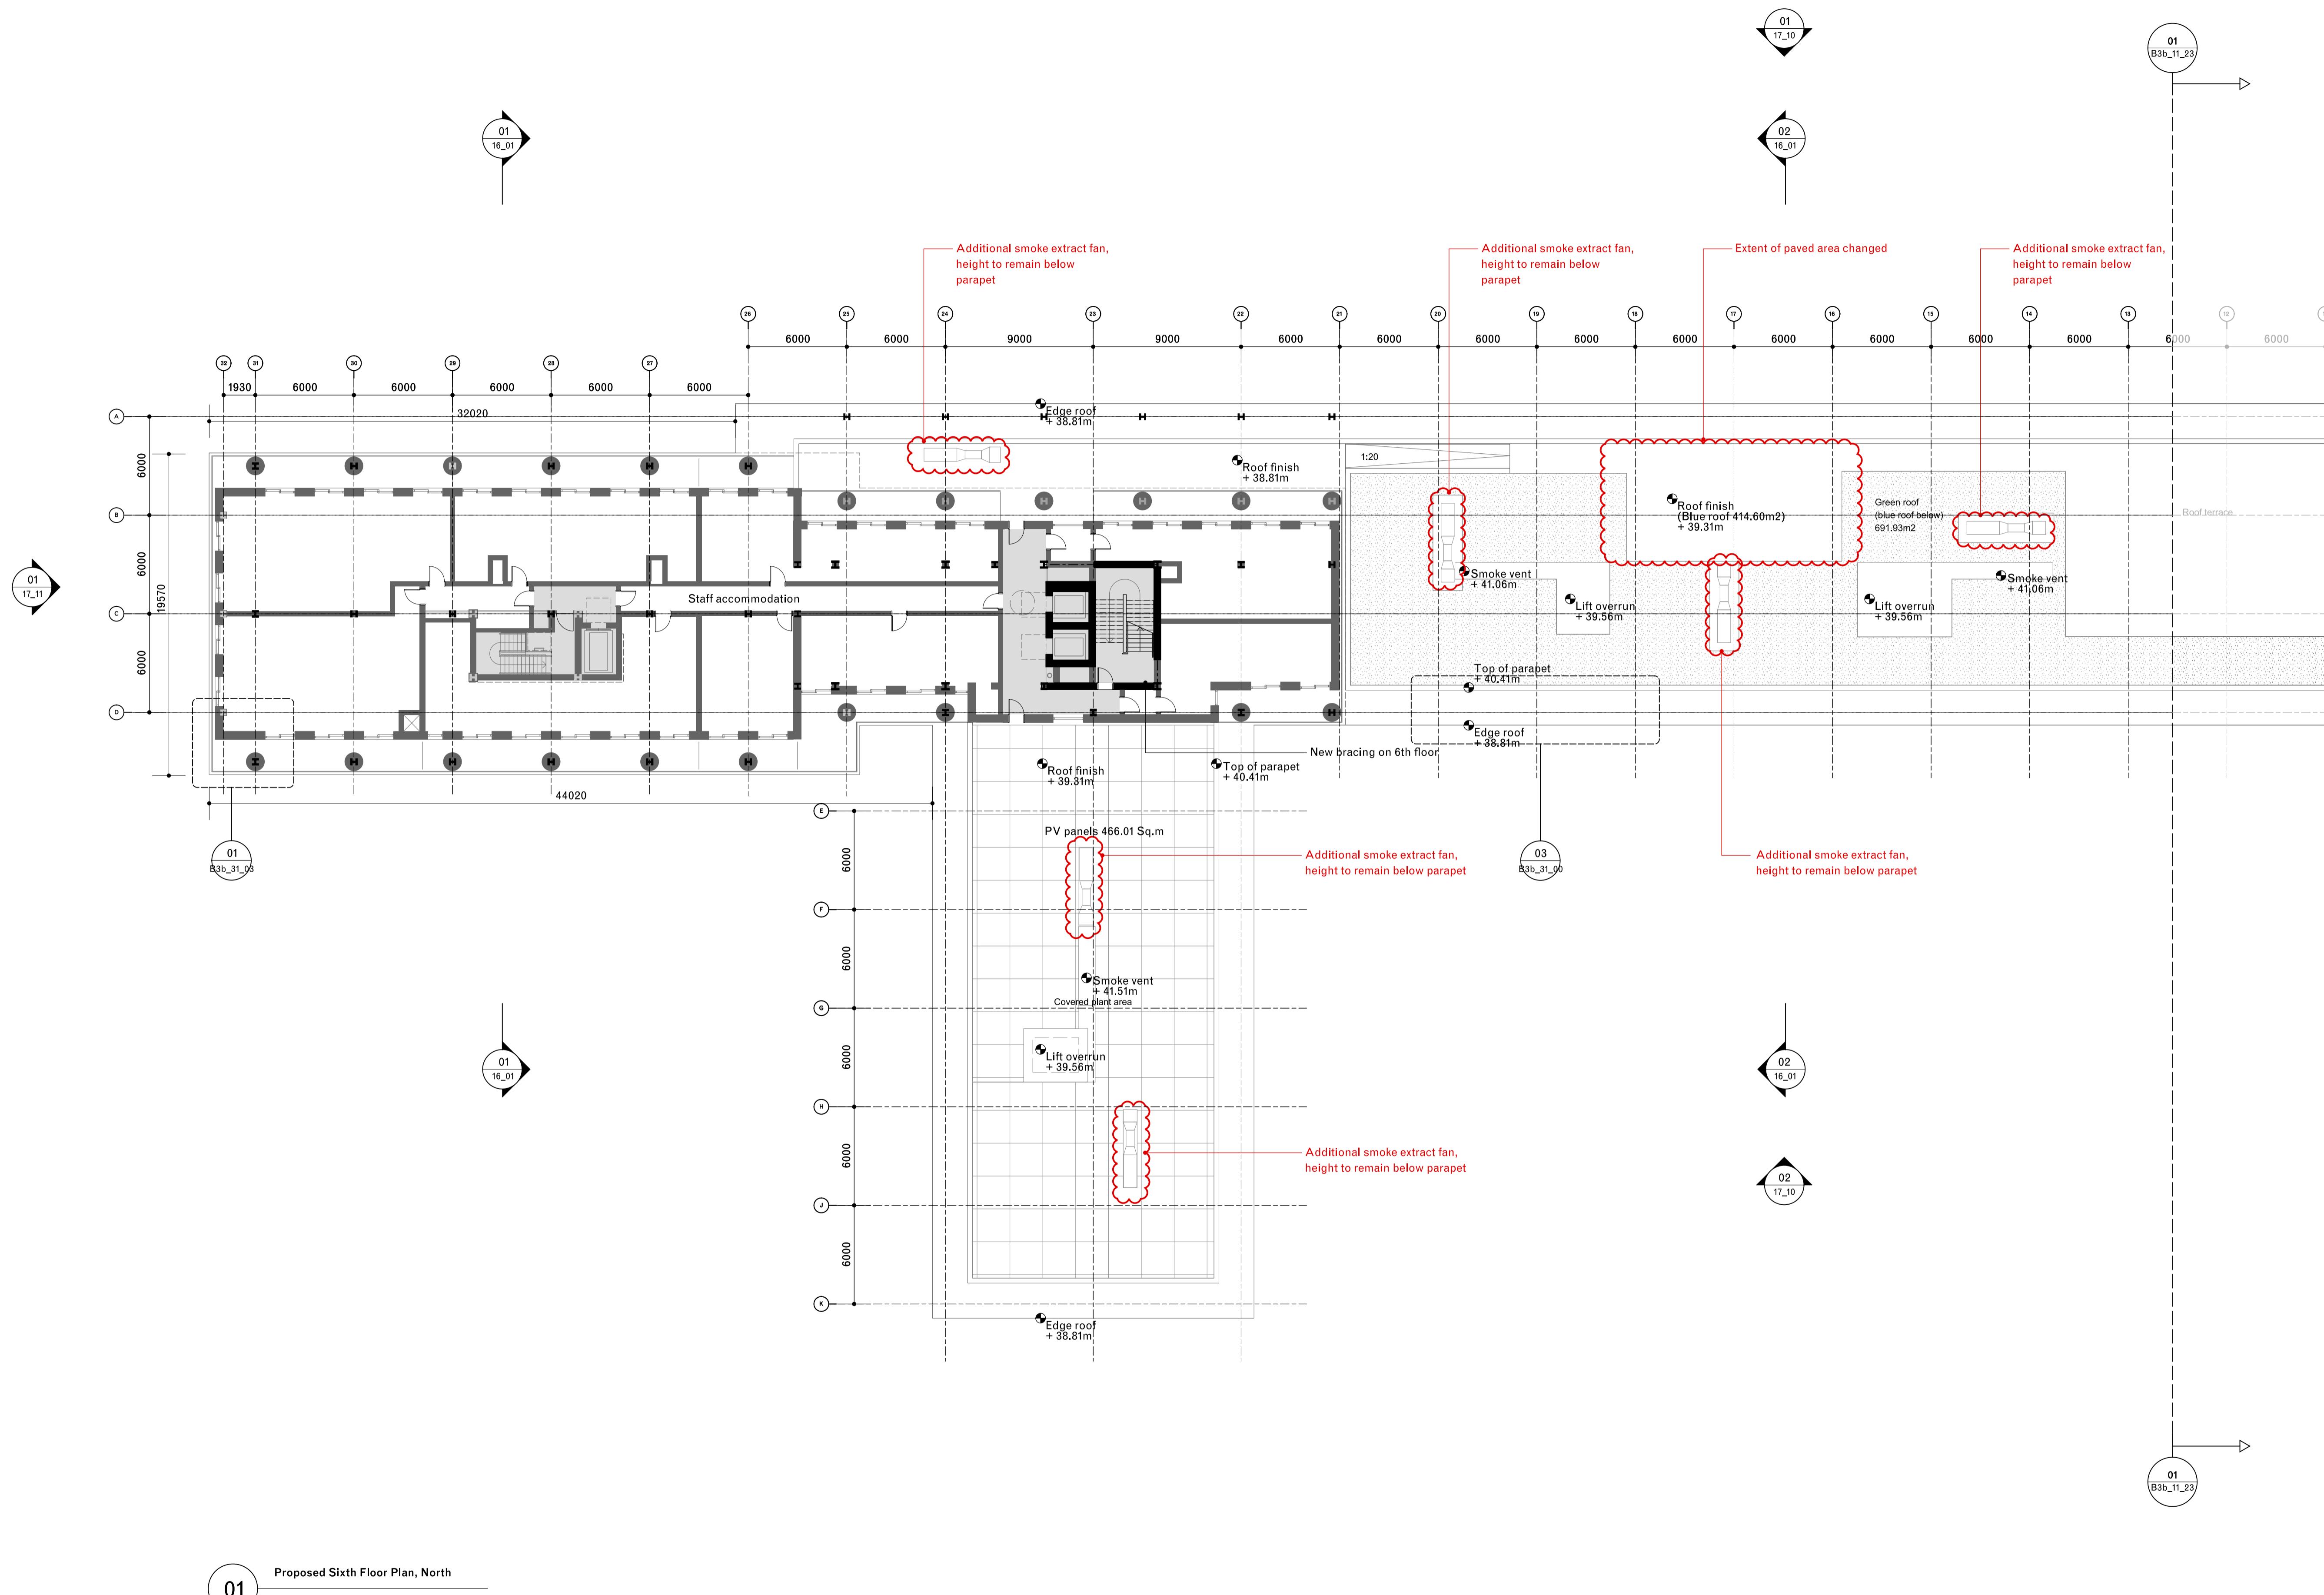

01 Proposed Sixth Floor Plan, North

Note:
Red line shows amendments made to the original 2021 application to ensure compliance with updated legislation, including the Building Safety Act 2022 and BS9991:2024, as presented at the Planning Inquiry.

General notes:

- Do not scale from drawings.
- Errors to be reported immediately to the Architect.
- To be read in conjunction with all relevant Architects', Services and Structural Engineers' drawings.
- All existing site, tree and building information has been compiled from different sources.
- All dimensions to be checked on site.

03	20/08/2025	Planning (addendum 3)	MY	GLa
02	31/01/2025	Planning (addendum 2)	MY	GLa
01	15/11/2024	Planning (addendum)	YZ	GLa

Part 10: Other Sub-Activities

C/O Fora, 9 Dallington Street
London EC1V 0LN
T +44 20 7620 4800
www.davidchipperfield.com


Project	Project number
Royal Mint Court	1510

Client

© David Chipperfield Architects Ltd.

Proposed sixth floor plan
Embassy House
North, sheet 1 of 2


Date	16/05/2024	Revision
Scale / Format	1:200 / A1	03
Drawn / Checked	THN / OU, GLa	Planning
Approved	BB	
CAD Reference	1510_A_B3b_11_22.dgn	

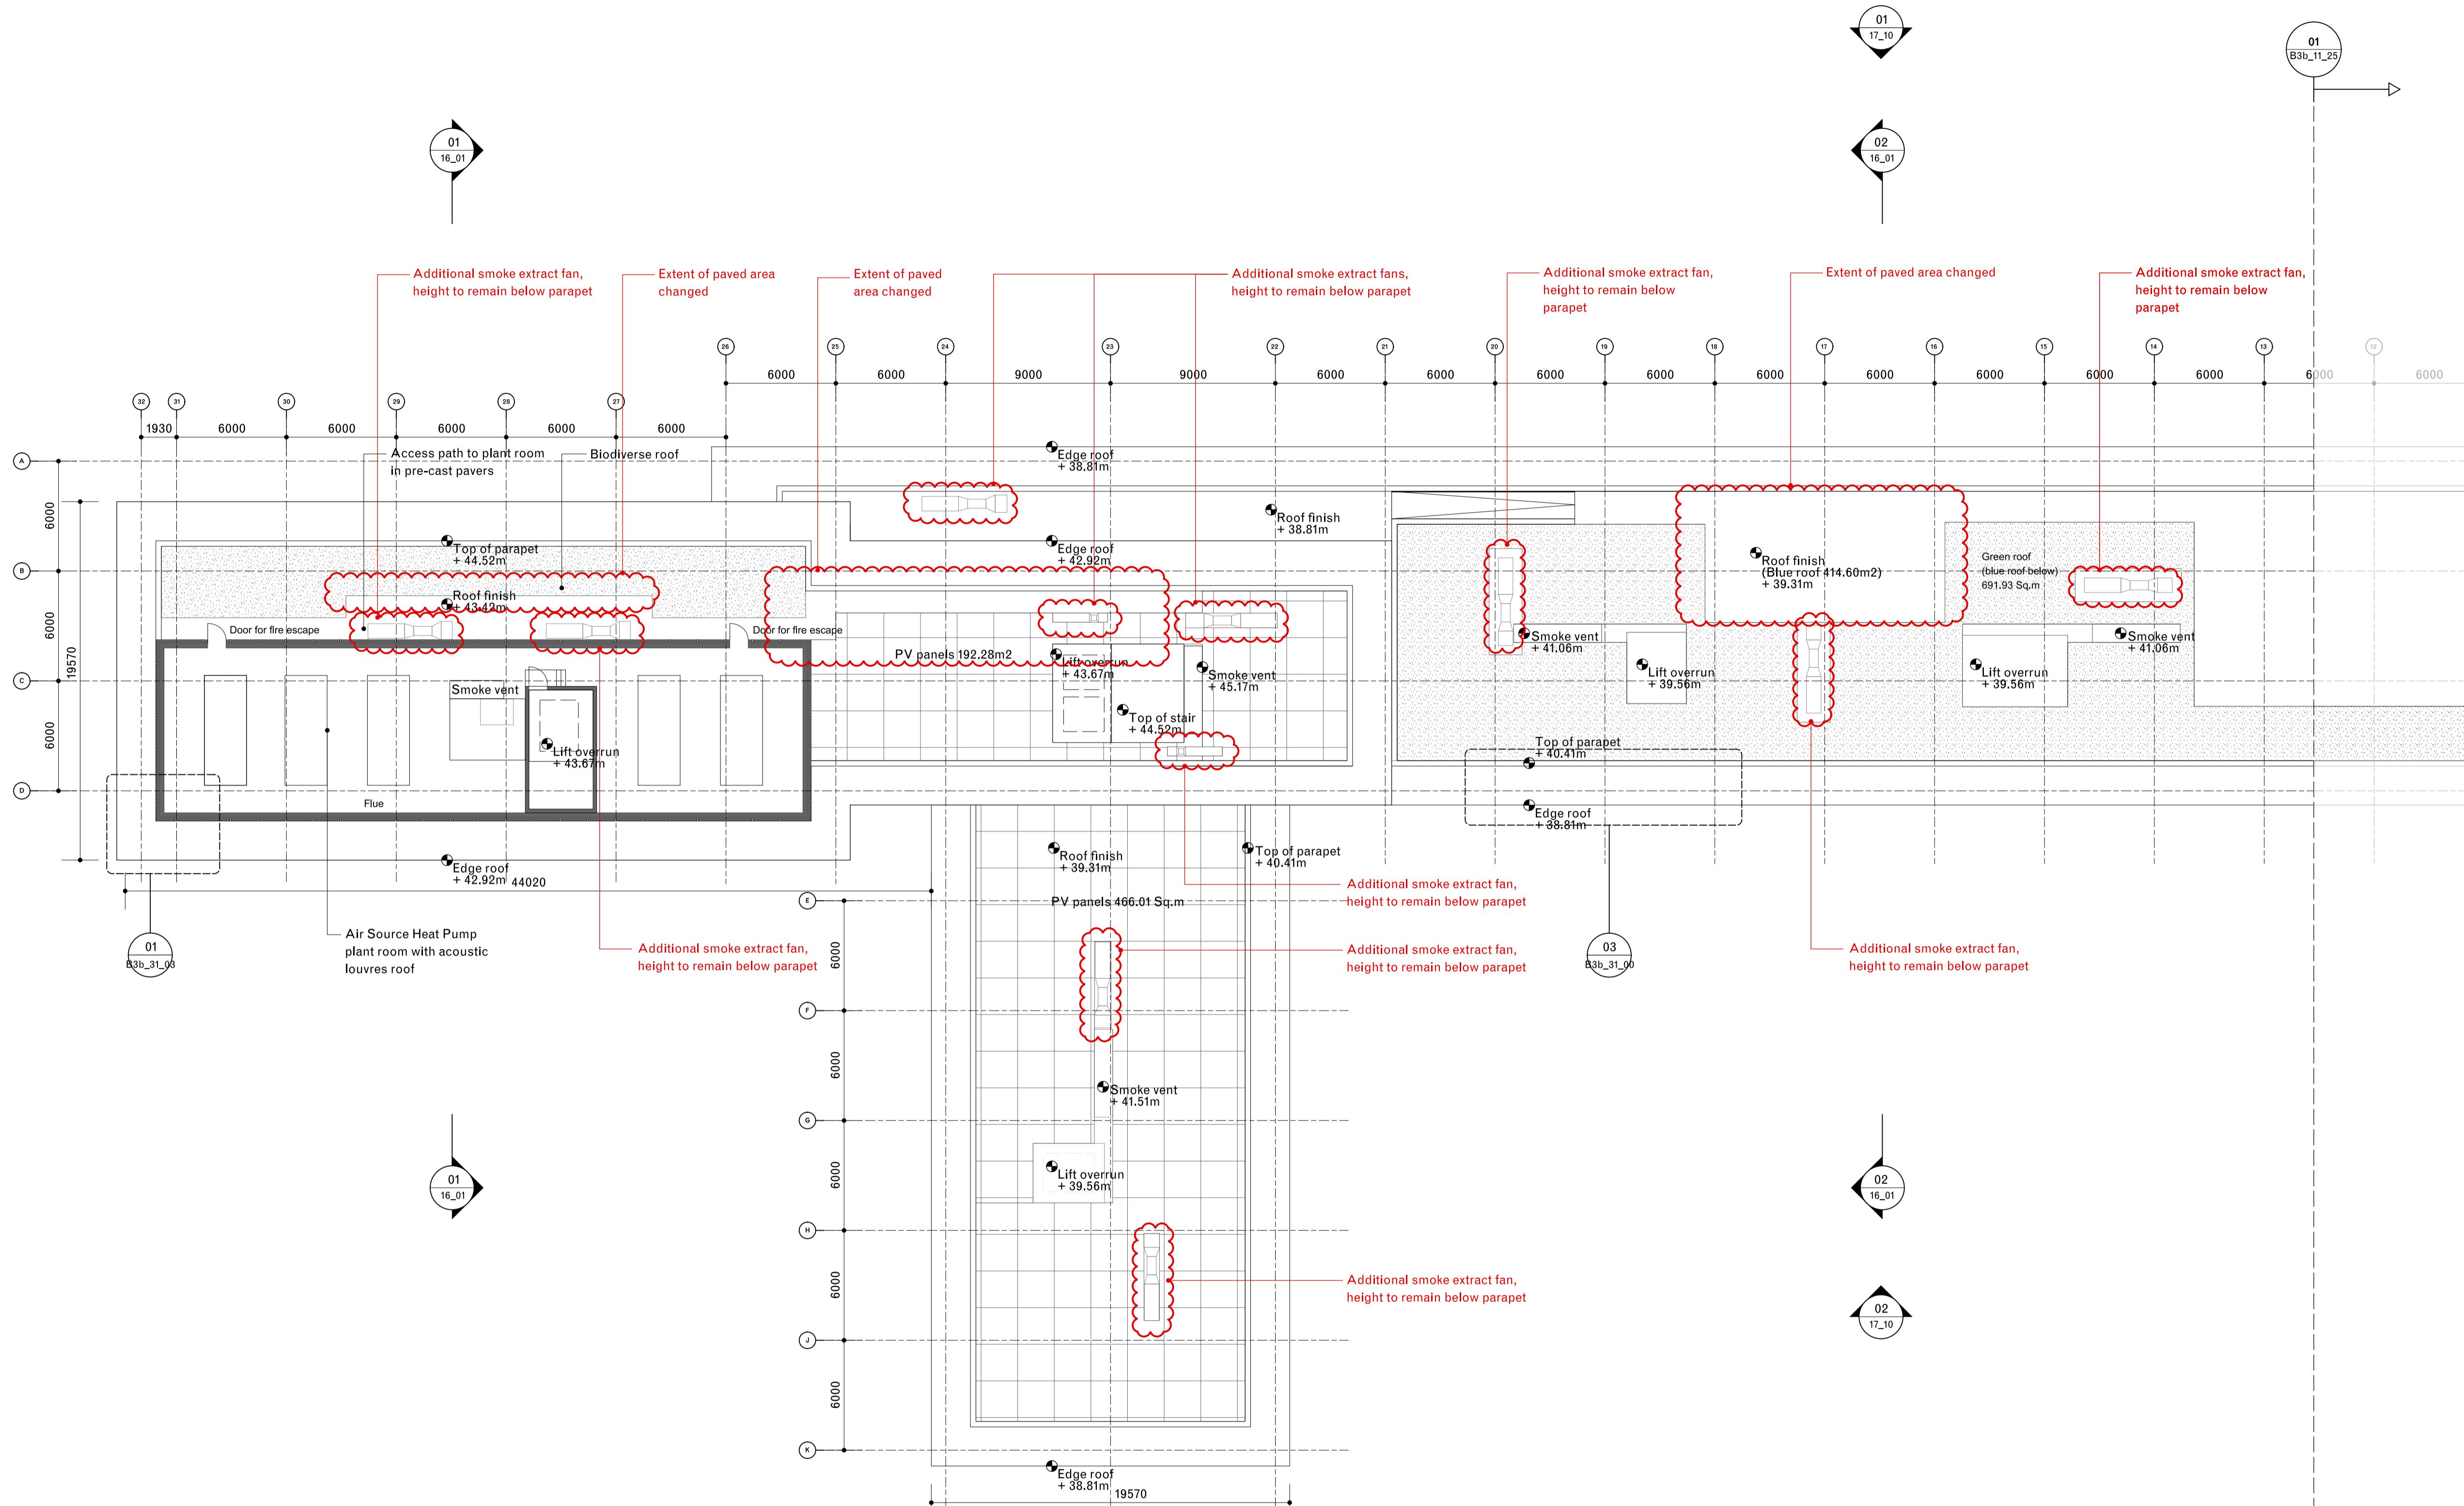

Note:
 Red line shows amendments made to the original 2021 application to ensure compliance with updated legislation, including the Building Safety Act 2022 and BS9991:2024, as presented at the Planning Inquiry.

General notes:
 Do not scale from drawings.
 Errors to be reported immediately to the Architect.
 To be read in conjunction with all relevant Architects', Services and Structural Engineers' drawings.
 All existing site, tree and building information has been compiled from different sources.
 All dimensions to be checked on site.

03 20/08/2025 Planning (addendum 3) MY GLa
 02 31/01/2025 Planning (addendum 2) MY GLa
 01 15/11/2024 Planning (addendum) YZ GLa
 Rev. Date Description Drawn Check

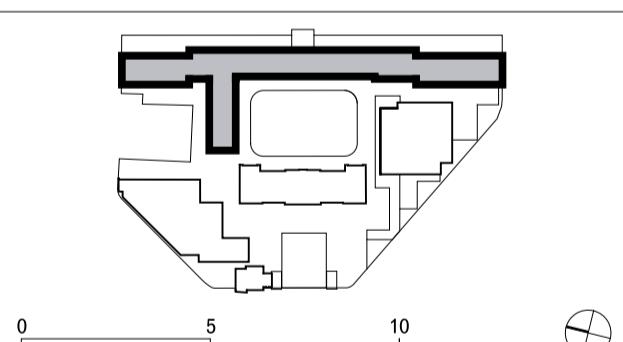

David Chipperfield Architects

C/O Fora, 9 Dillington Street
 London EC1V 8LW
 T +44 20 7829 4800
 www.davidchipperfield.com

Project Royal Mint Court
 Project number 1510

Client Chinese Embassy in the UK

© David Chipperfield Architects Ltd.

Planning (addendum)

Drawing name Drawing number

Proposed seventh floor plan
 Embassy house
 North, sheet 1 of 2

16/05/2024

1:200 / A1

YZ / OU, GLa

BB

Planning

03

Date Scale / Format Revision
 Drawn / Checked
 Approved
 CAD Reference

16/05/2024

1:200 / A1

YZ / OU, GLa


BB

Planning

1510_A_B3b_11_24.dgn

01
 Proposed Seventh Floor Plan
 Scale 1:200

03

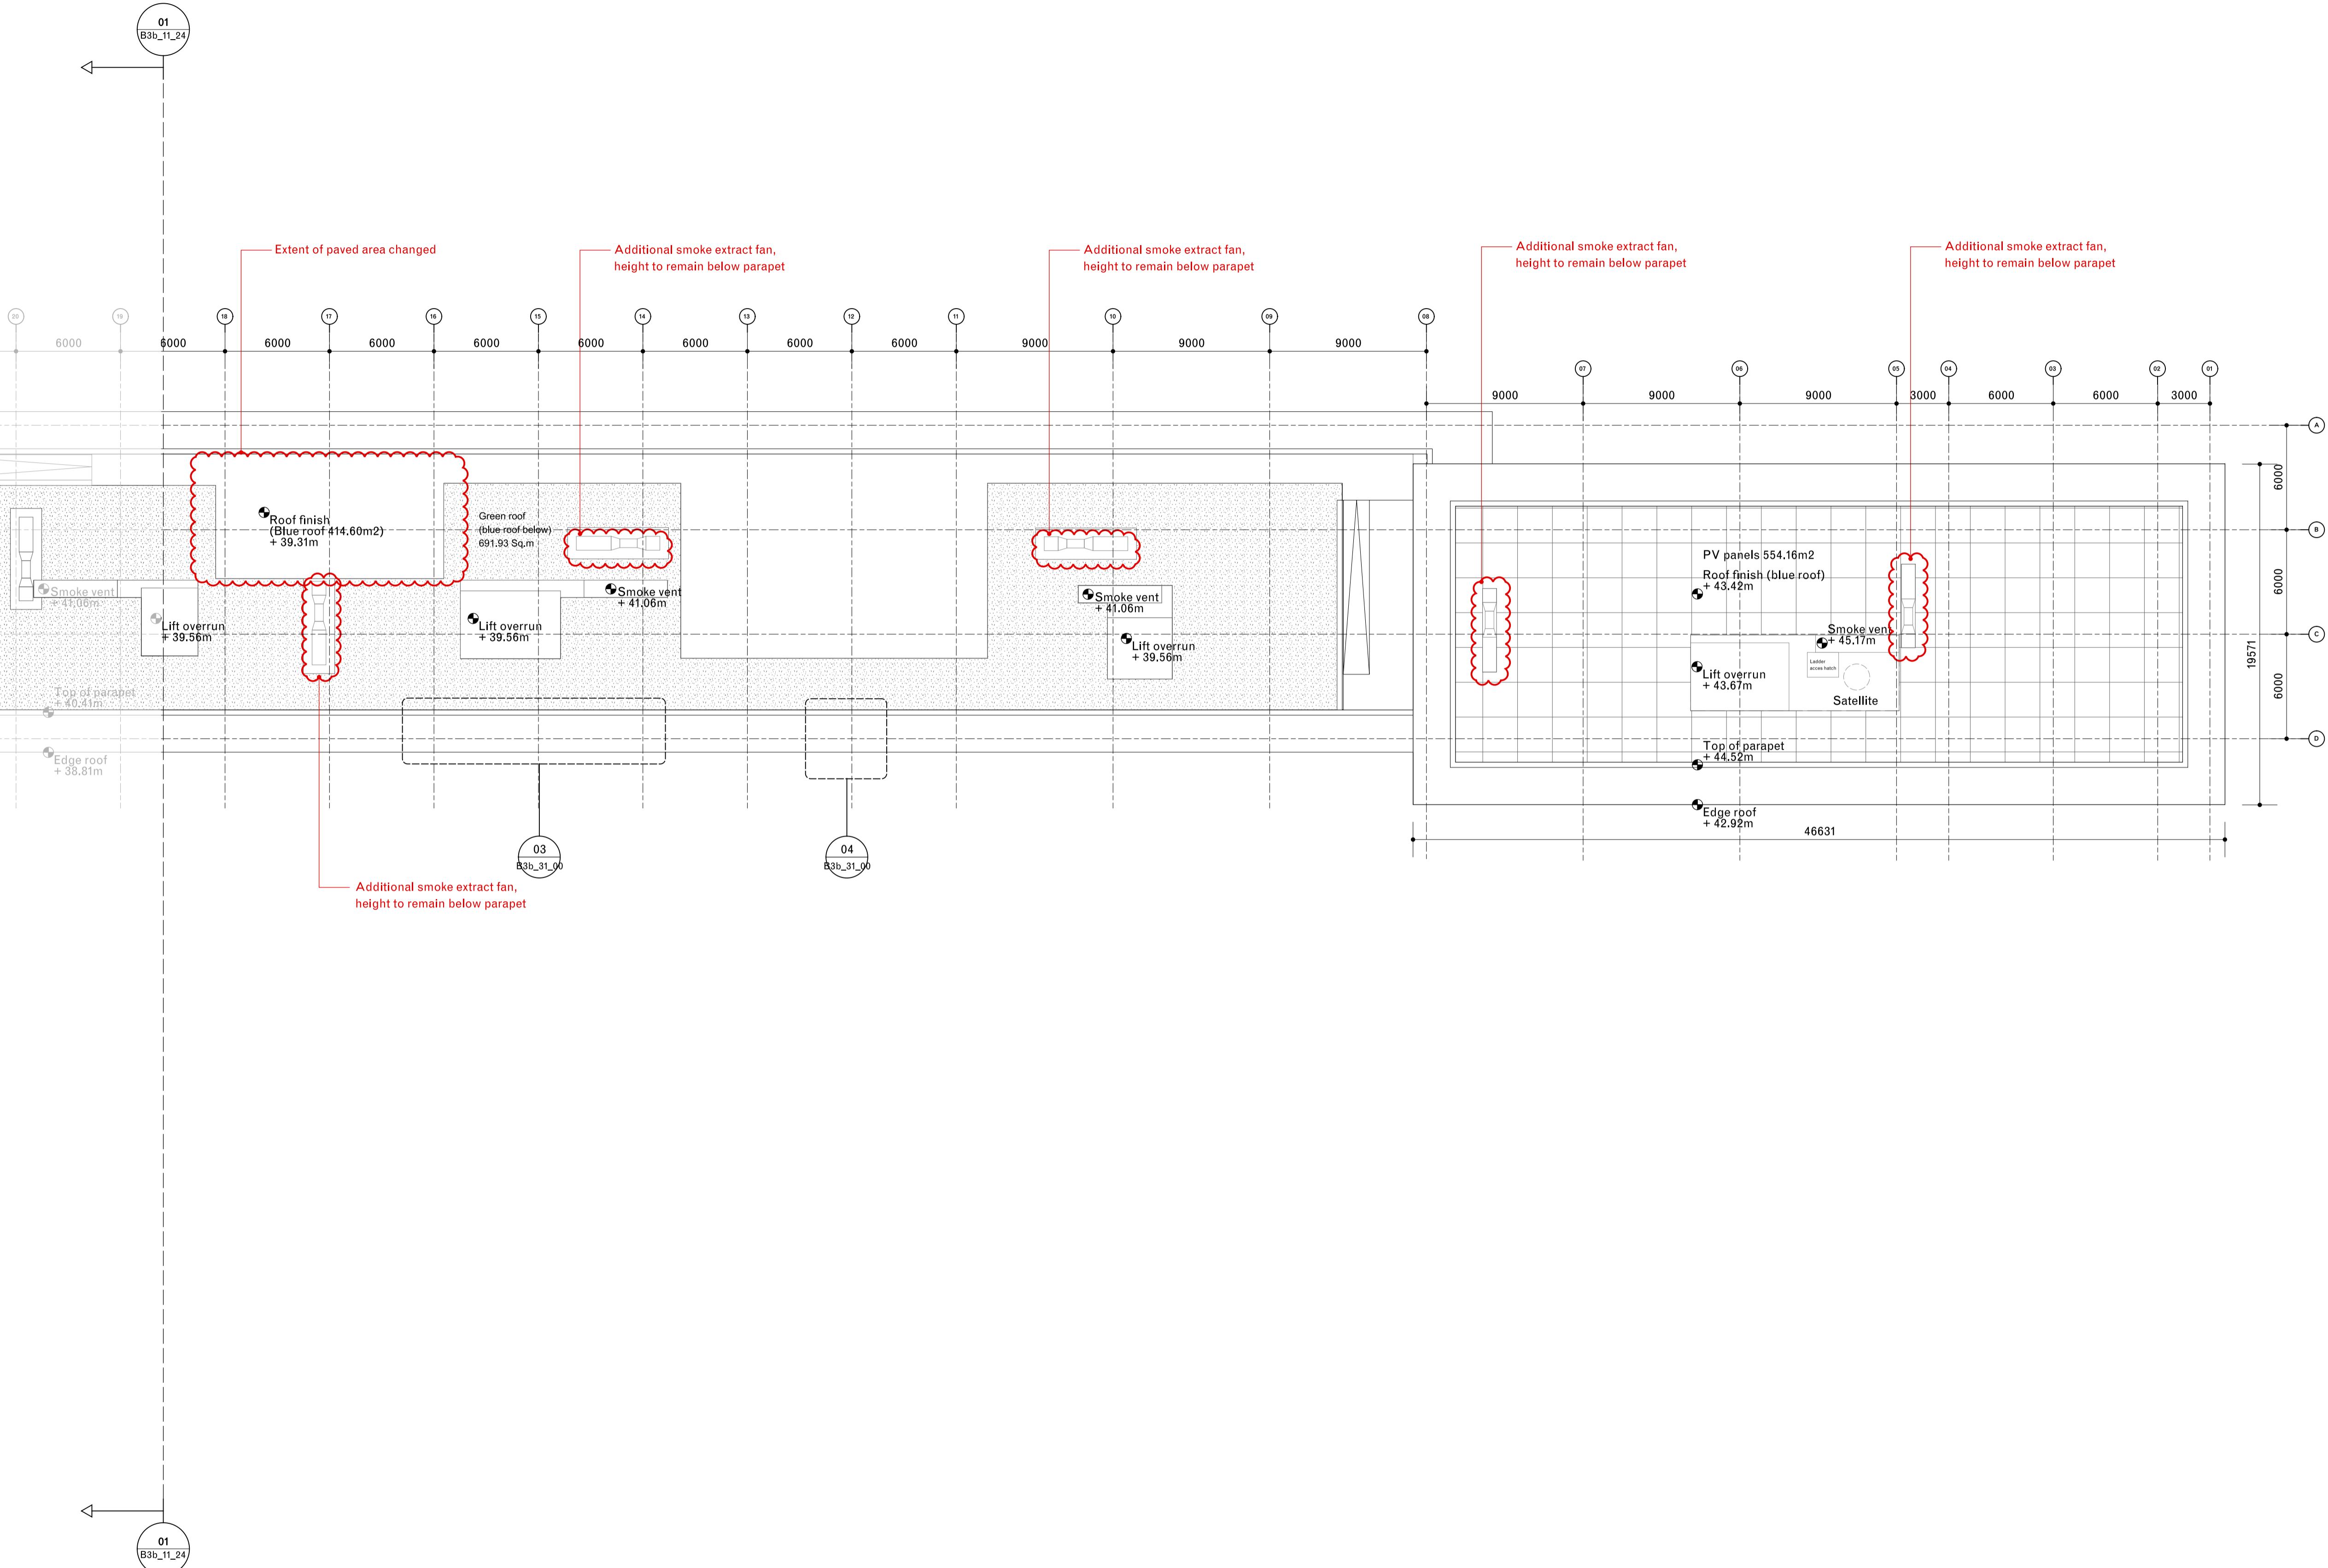

01
B3b_11_24
Proposed Seventh Floor Plan
Scale 1:200


Note:
Red line shows amendments made to the original 2021 application to ensure compliance with updated legislation, including the Building Safety Act 2022 and BS9991:2024, as presented at the Planning Inquiry.

General notes:
Do not scale from drawings.
Errors to be reported immediately to the Architect.
To be read in conjunction with all relevant Architects', Services and Structural Engineers' drawings.
All existing site, tree and building information has been compiled from different sources.
All dimensions to be checked on site.

02
17_11

Existing
Proposed
Retained column
New column

03	20/08/2025 Planning (addendum 3)	MY	GLa
02	31/01/2025 Planning (addendum 2)	MY	GLa
01	15/11/2024 Planning (addendum)	YZ	GLa
Rev.	Date	Description	Drawn

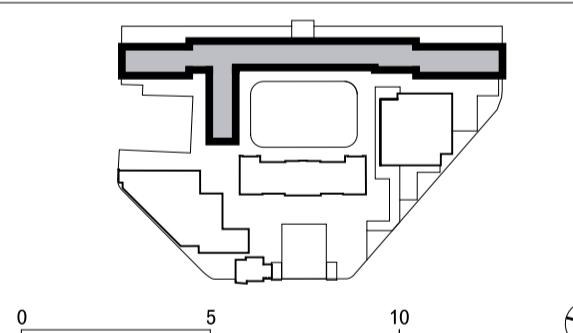

David Chipperfield Architects

C/O Fora, 9 Dillington Street
London EC1V 8LP
T +44 20 7829 4800
www.davidchipperfield.com

Project
Royal Mint Court
1510

Client
Chinese Embassy in the UK

© David Chipperfield Architects Ltd.

Planning (addendum)

Drawing name
Proposed seventh floor plan

Drawing number

Embassy house
South, sheet 2 of 2

Date
16/05/2024

Scale / Format
1:200 / A1

Revision
03

Drawn / Checked
YZ / OU, GLa


Approved
BB

CAD Reference
1510_A_B3b_11_25.dgn

Planning

03

Planning

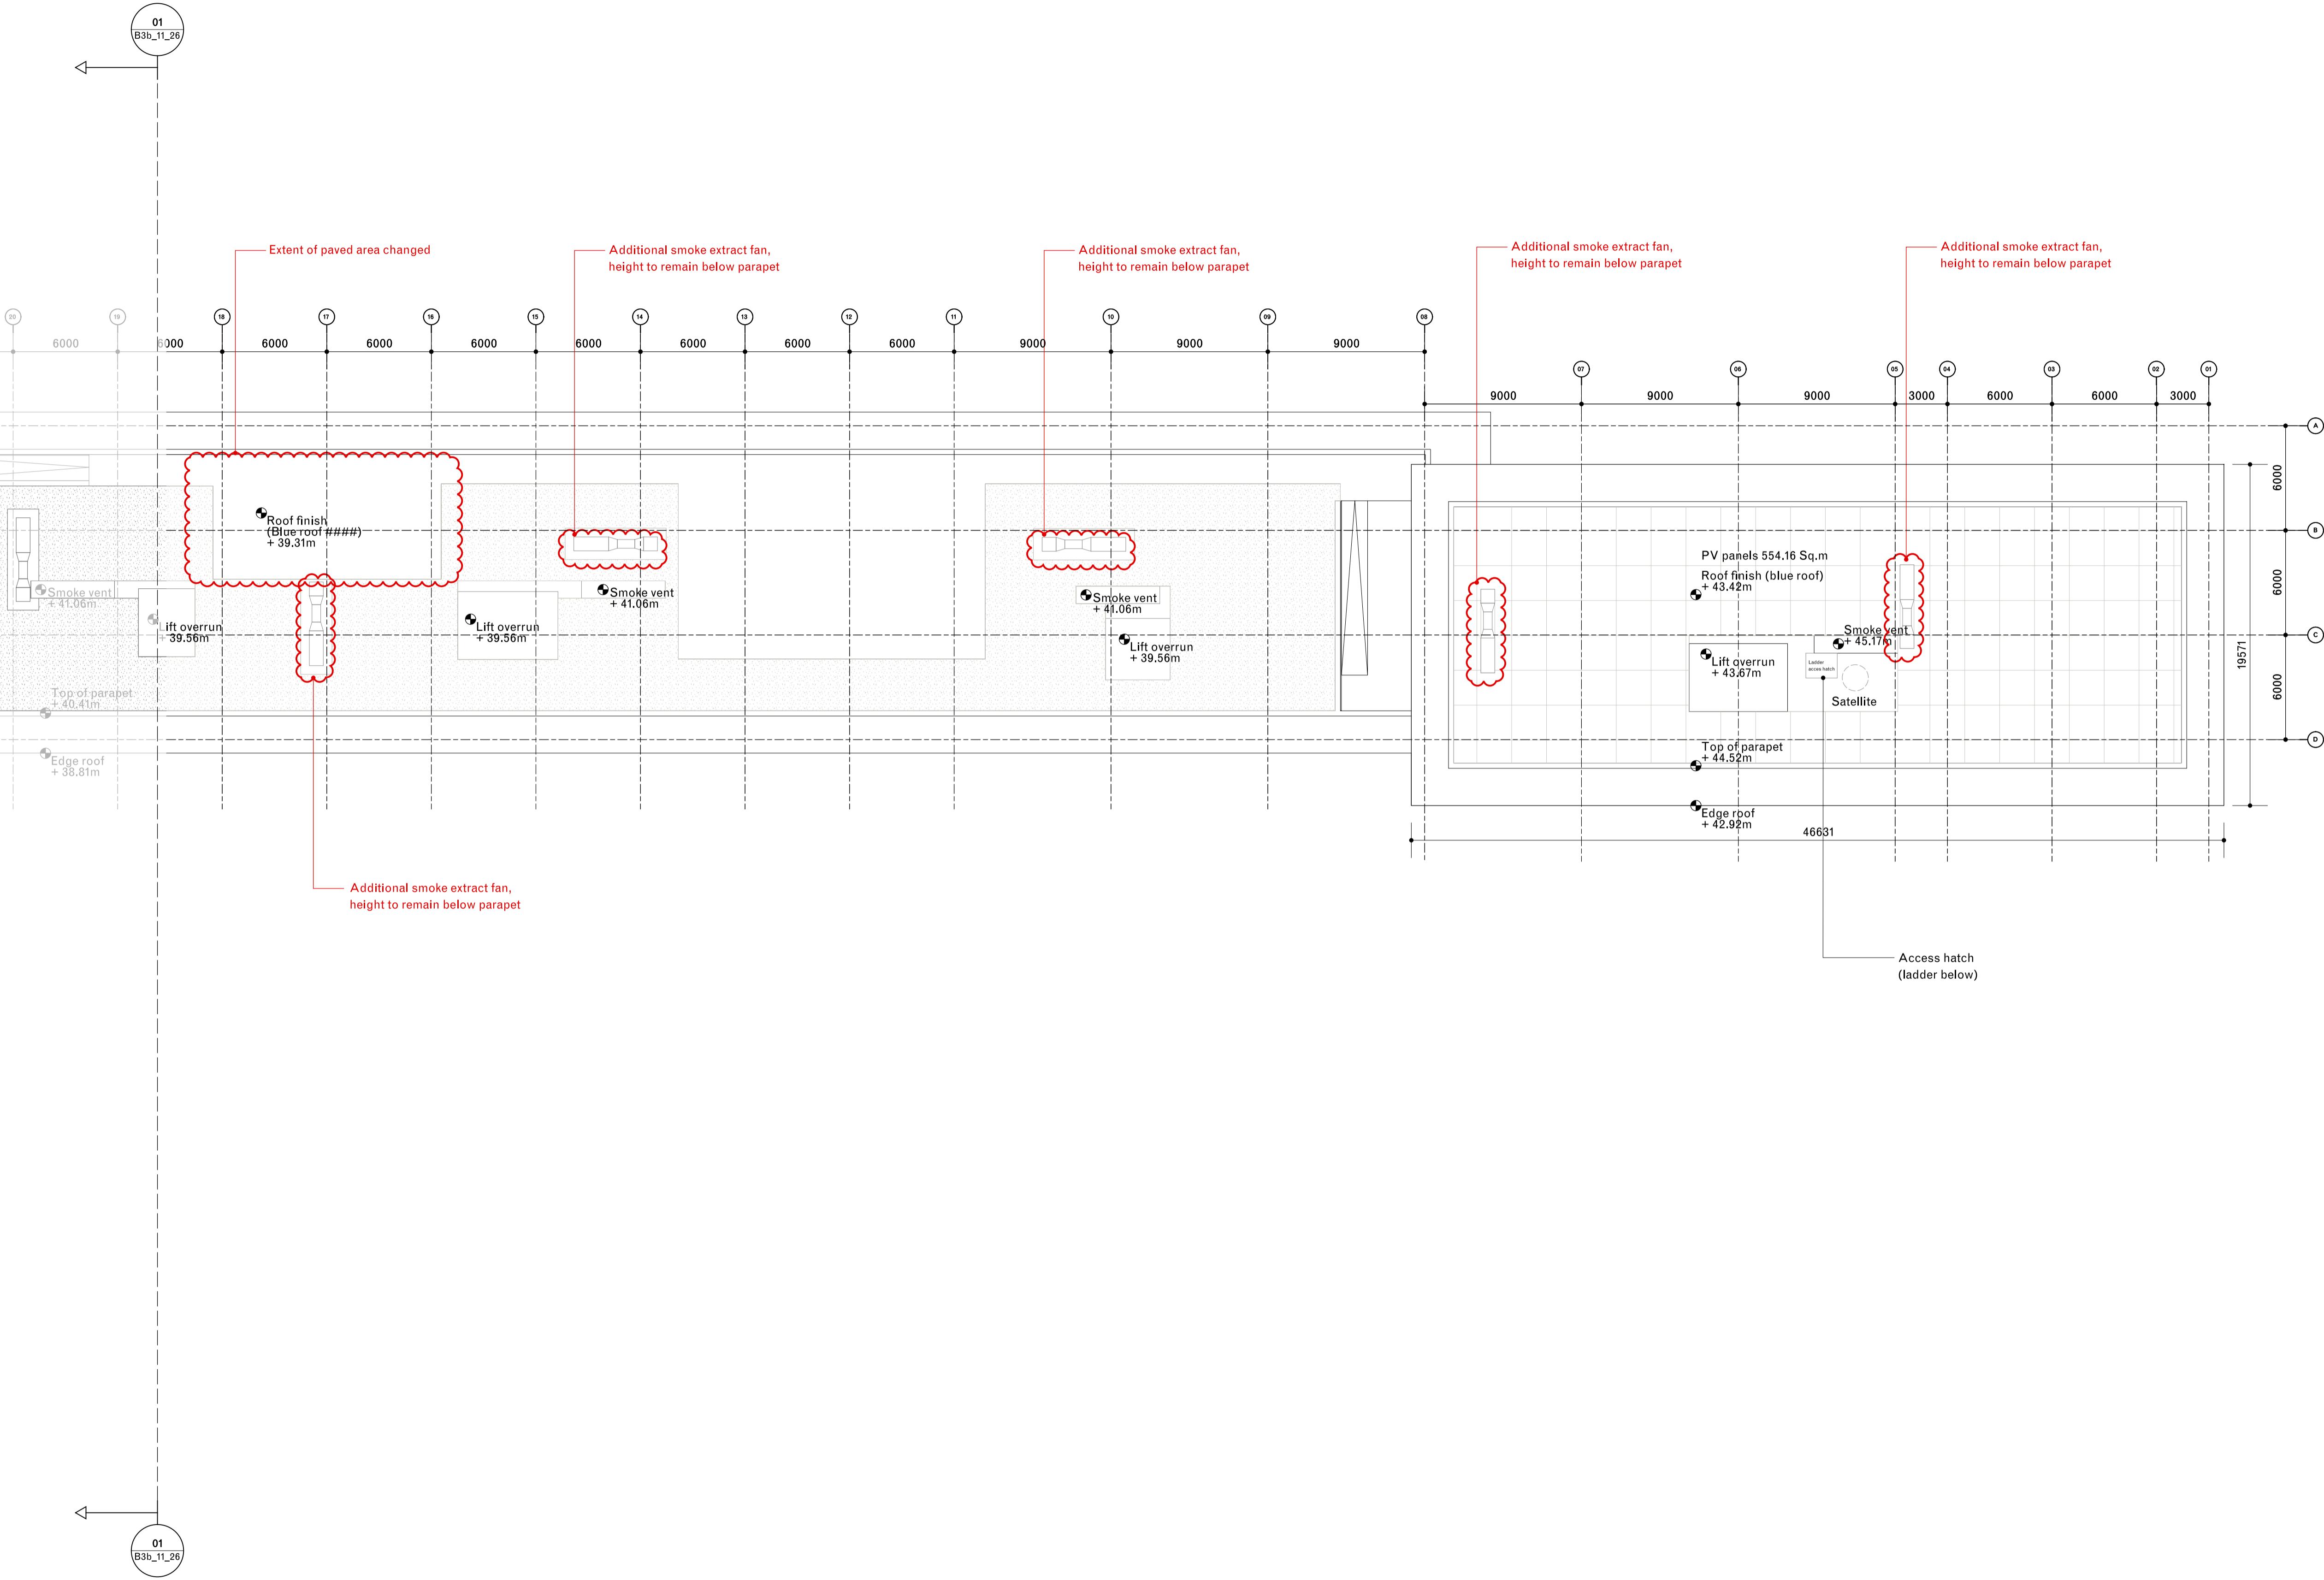


Note:
Red line shows amendments made to the original 2021 application to ensure compliance with updated legislation, including the Building Safety Act 2022 and BS9991:2024, as presented at the Planning Inquiry.

General notes:
Do not scale from drawings.
Errors to be reported immediately to the Architect.
To be read in conjunction with all relevant Architects', Services and Structural Engineers' drawings.
All existing site, tree and building information has been compiled from different sources.
All dimensions to be checked on site.

Existing
Proposed

03 20/08/2025 Planning (addendum 3) MY GLa
02 31/01/2025 Planning (addendum 2) MY GLa
01 15/11/2024 Planning (addendum) YZ GLa
Rev. Date Description Drawn Check

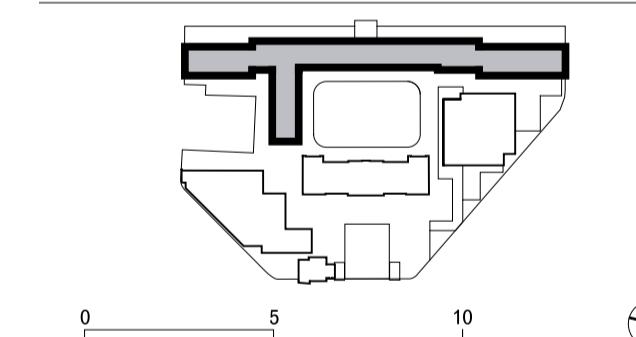

David Chipperfield Architects

C/O Fora, 9 Dillington Street
London EC1V 8LW
T +44 20 7829 4800
www.davidchipperfield.com

Project Royal Mint Court
Project number 1510

 
Client Chinese Embassy in the UK

Planning (addendum)
Drawing name Proposed roof plan
Drawing number Embassy House
South, sheet 2 of 2
Date 16/05/2024
Scale / Format 1:200 / A1
Drawn / Checked RPI / OU, GLa
Approved BB
CAD Reference 1510_A_B3b_11_27.dgn
Revision 03
Planning


© David Chipperfield Architects Ltd.

Planning

03



02 20080903Planning (addendum 3) MY GLa
01 16/11/2024 Planning (addendum) YZ GLa
Rev. Date Description Drawn Checked
16/05/2024 1:200 A0
16/05/2024 1:200 A0
Approved B4
CAD Reference 1510_a_b4_11_09.dgn

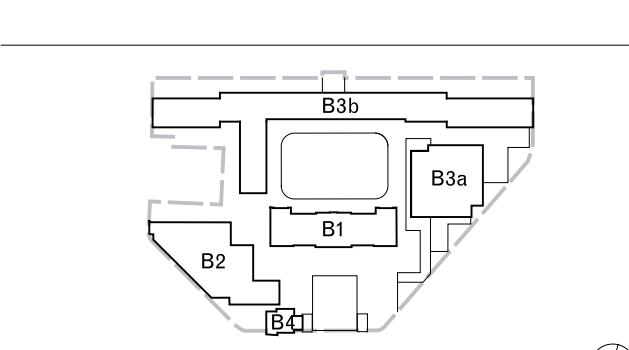

David Chipperfield Architects

© David Chipperfield Architects Ltd.
CIO Fora, 9 Dallington Street
London EC1V 9DZ
T +44 20 7629 8800
www.davidchipperfield.com

Project Royal Mint Court Project number 1510

Client Chinese Embassy in the UK

Planning (addendum)

Drawing name Proposed basement plan Drawing number Masterplan B4-11_09

Date 16/05/2024
Scale / Format 1:200 A0
Drawn / Checked YZ GLa
Approved B4
CAD Reference 1510_a_b4_11_09.dgn

